

Site Name: PACIFICO

Site ID #: LA57XC302

AMENDMENT NO. 1 TO WIRELESS COMMUNICATIONS SITE LICENSE AGREEMENT

This Amendment No. 1 to Wireless Communications Site License Agreement (this "**Amendment**"), effective as of the date last signed below ("**Effective Date**"), amends a certain License between Sprint PCS Assets, L.L.C., a Delaware limited liability company ("**Licensee**"), and CITY OF HERMOSA BEACH ("**Licensor**"), dated November 12, 2003 [agreement date]

BACKGROUND

WHEREAS, Tenant desires to expand the Site by approximately 25 square feet of space in order to provide for additional facilities to be installed at the Site.

WHEREAS, Licensee desires to modify its installation on the Site by adding or swapping out antennas and other equipment to the Facilities, as more particularly described in Exhibit A-3 annexed hereto, and Licensee and Licensor desire to modify the provisions of the Agreement as provided below.

AGREEMENT

For good and valuable consideration, the receipt and sufficiency of which are acknowledged, Licensor and Licensee agree as follows:

1. **Premises and Use.** Section 1 of the Agreement is deleted in its entirety and replaced by the following:
 - a. Licensor owns the real property located in the City of Hermosa Beach, County of Los Angeles, which is described in Exhibit A-1 attached hereto and incorporated herein by this reference ("Land"). Subject to the following terms and conditions, Licensor grants to Licensee a non-exclusive right to use approximately 315 square feet of the Land, including applicable non-exclusive easements for site access and utilities as described and/or shown in Exhibit A-2 and A-3 attached hereto and incorporated herein by this reference ("Premises"), to erect, maintain and operate mobile/wireless communication facilities.
 - b. Licensee acknowledges that Licensor will deliver the Premises in "as is" condition, without warranty, express or implied, as to its condition or usability, except as otherwise expressly set forth in this Agreement.
2. **Modification to the Site.** Exhibit A-2 to the Agreement is hereby amended to include the modifications identified on Exhibit A-3, a copy of which is attached and made a part hereof. Exhibit A-3 supplements Exhibit A-2 to the Agreement and shall not be deemed to supersede or otherwise modify Exhibit A-2 or any part thereof except to the extent specifically set forth in Exhibit A-3. Upon full execution of this Amendment, Licensee is permitted to do all work necessary to prepare, maintain and alter the Site to install or otherwise modify the Site, all as more fully described and contemplated in Exhibit A-3.
3. **Modification to Rent.** Section 5 of the Agreement is amended to add a new Section 5(c) to read as follows:

As additional consideration for the modification and other rights set forth in this Amendment, starting on the date that is 30 days after the start of construction of the modifications to the Facilities, the monthly rent will be increased by \$250.00.

4. **Expiration or Termination of this Amendment.** If Licensee does not utilize the rights and entitlements provided in this Amendment, Licensee may terminate this Amendment effective as of the date of such written notice. After termination of this

Amendment, the terms and conditions of the Agreement as they existed immediately prior to the Effective Date of this Amendment shall be deemed reinstated, ratified and affirmed, and shall continue in full force and effect. After termination of this Amendment, Rent shall revert to the amount in effect immediately prior to the Effective Date of this Amendment, plus any rental increases, including annual escalators or rent increases due to other site modifications made by Licensee, which occurred during the period of time between the Effective Date of this Amendment and the termination date of this Amendment.

5. **General Terms and Conditions.**

a. All capitalized terms used in this Amendment, unless otherwise defined herein, will have the same meaning as the terms contained in the Agreement.

b. In case of any inconsistencies between the terms and conditions contained in the Agreement and the terms and conditions contained in this Amendment, the terms and conditions herein will control. Except as set forth herein, all provisions of the Agreement are ratified and remain unchanged and in full force and effect.

c. This Amendment may be executed in duplicate counterparts, each of which will be deemed an original.

d. Each of the parties represents and warrants that it has the right, power, legal capacity and authority to enter into and perform its respective obligations under this Amendment.

*****SIGNATURES ON FOLLOWING PAGE*****

The parties have executed this Amendment as of the Effective Date.

Licensors:

City of Hermosa Beach

Licensee:

Sprint PCS Assets, L.L.C., a Delaware limited liability company

By: _____

Printed Name: _____

Title: _____

Date: _____
(Date must be completed)

By: _____

Printed Name: _____

Title: _____

Date: _____
(Date must be completed)

EXHIBIT A-1

DESCRIPTION OF LAND


The real property situated in Los Angeles County, State of California, particularly described as:


A PARCEL OF LAND IN THE CITY OF HERMOSA BEACH, IN THE COUNTY OF LOS ANGELES, STATE OF CALIFORNIA, BEING A PORTION OF LOT 29 BLOCK 14, OF HERMOSA BEACH, AS PER MAP RECORDED IN BOOK 1, PAGES 25 AND 26 OF MAPS, IN THE OFFICE OF THE COUNTY RECORDER OF SAID COUNTY, DESCRIBED AS FOLLOWS:

BEGINNING AT THE NORTHEAST CORNER OF SAID LOT 29; THENCE SOUTH 12° 11' 09" EAST 95' ALONG THE EASTERLY LINE OF SAID LOT TO THE SOUTHEASTERLY CORNER THEREON; THENCE SOUTH 77° 26' 05" WEST 23.84' ALONG THE SOUTHERLY LINE OF SAID LOT; THENCE NORTH 12° 34' 44" WEST 95' TO A POINT ON THE NORTHERLY LINE OF SAID LOT, BEARING SOUTH 77° 26' 09" WEST 24.50' FROM THE NORTHEAST CORNER OF SAID LOT 29; THENCE NORTH 77° 26' 03" EAST 24.50' ALONG THE NORTHERLY LINE OF SAID LOT TO THE POINT OF BEGINNING.

Exhibit A-2


[see attached]

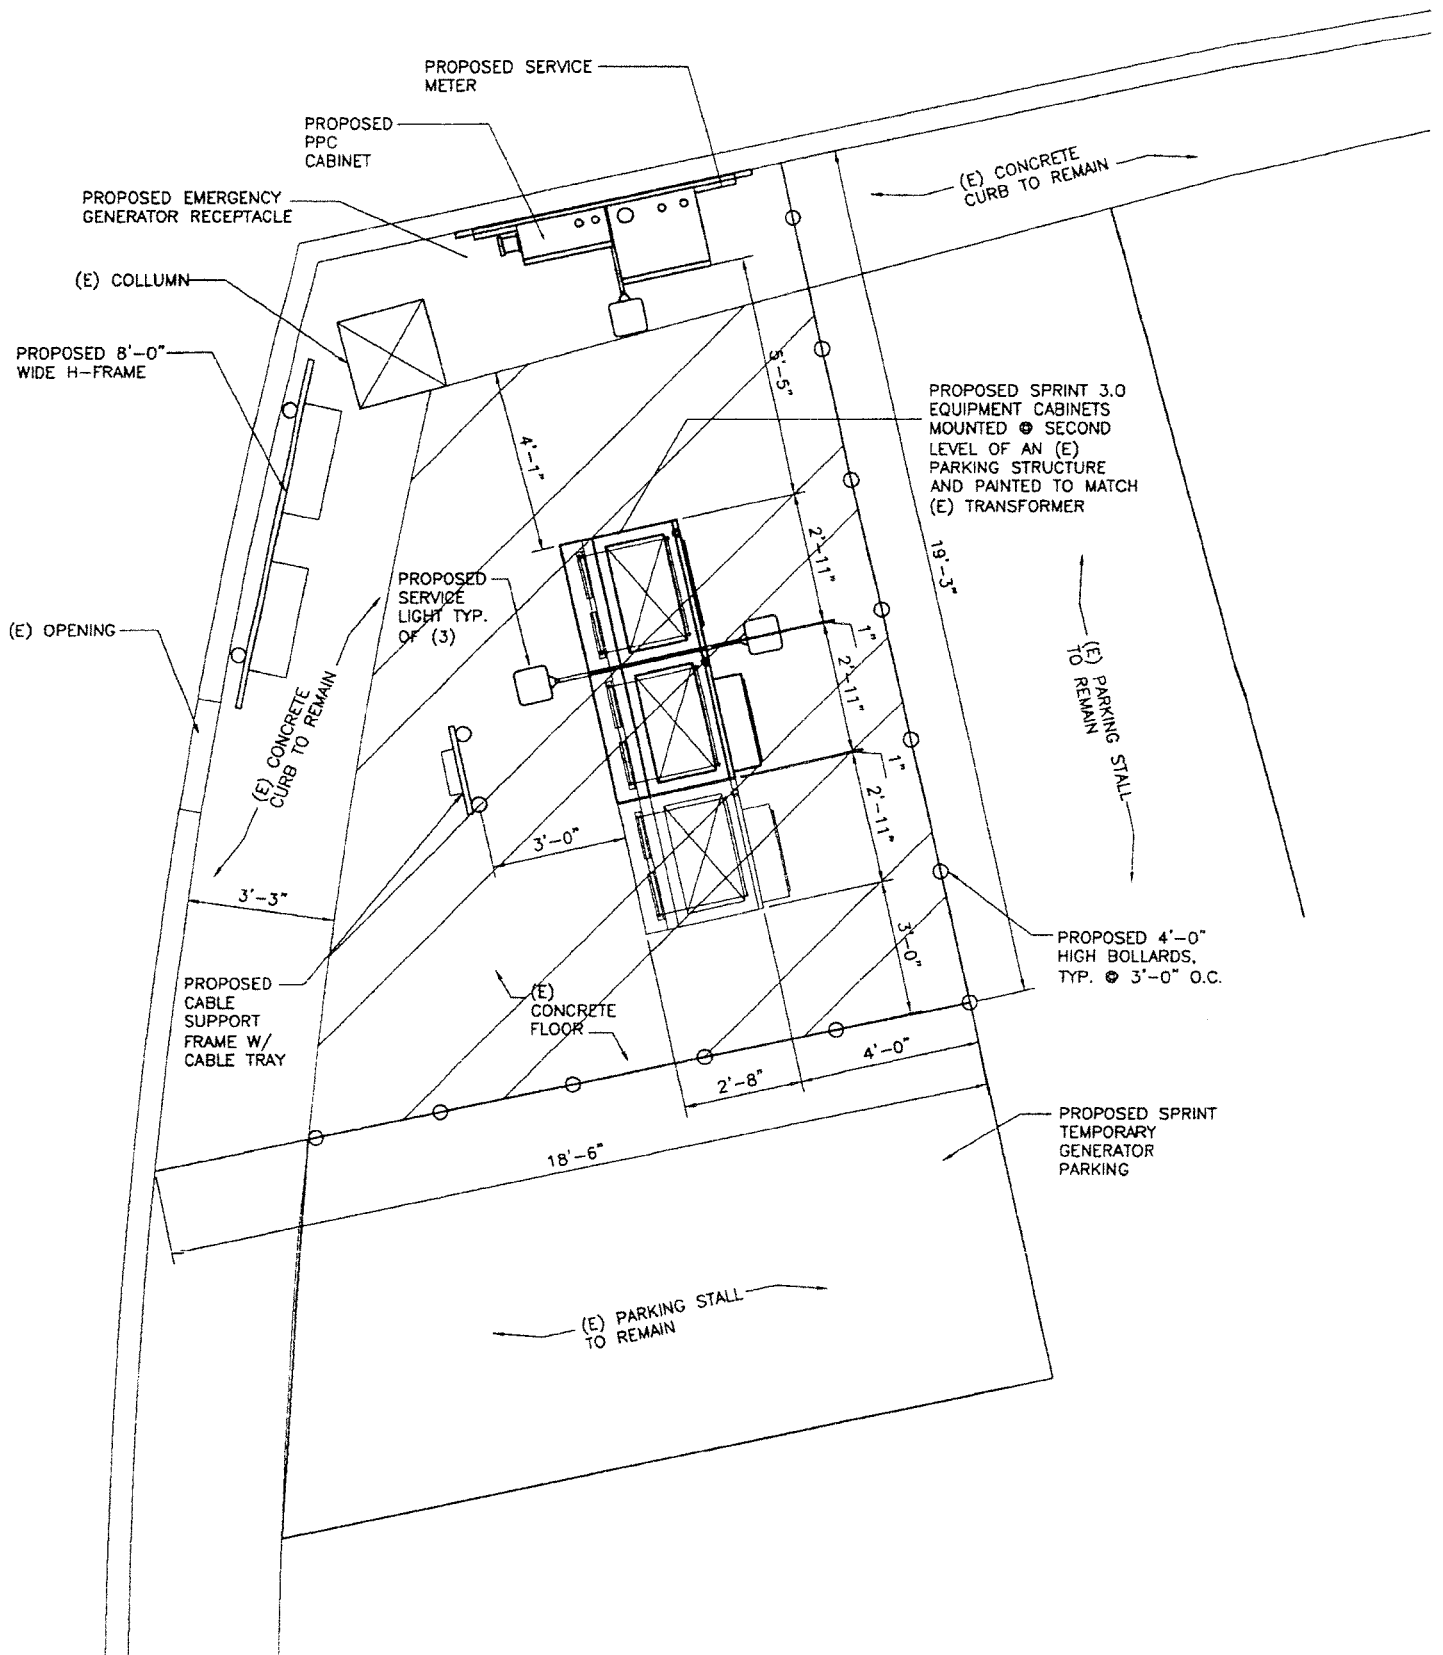

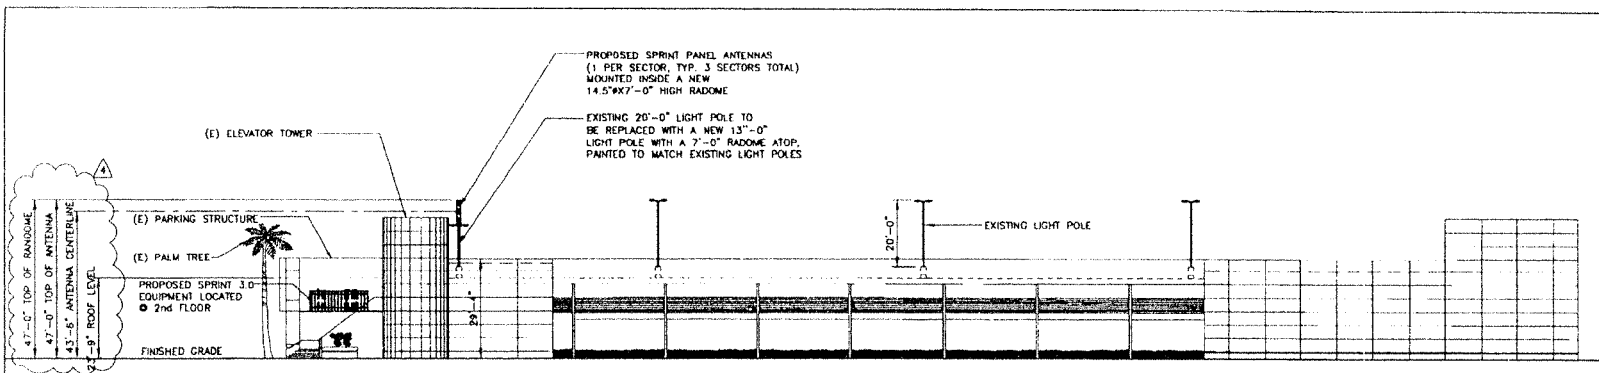


SOUTH ELEVATION

SCALE: 1/8" = 1'-0"

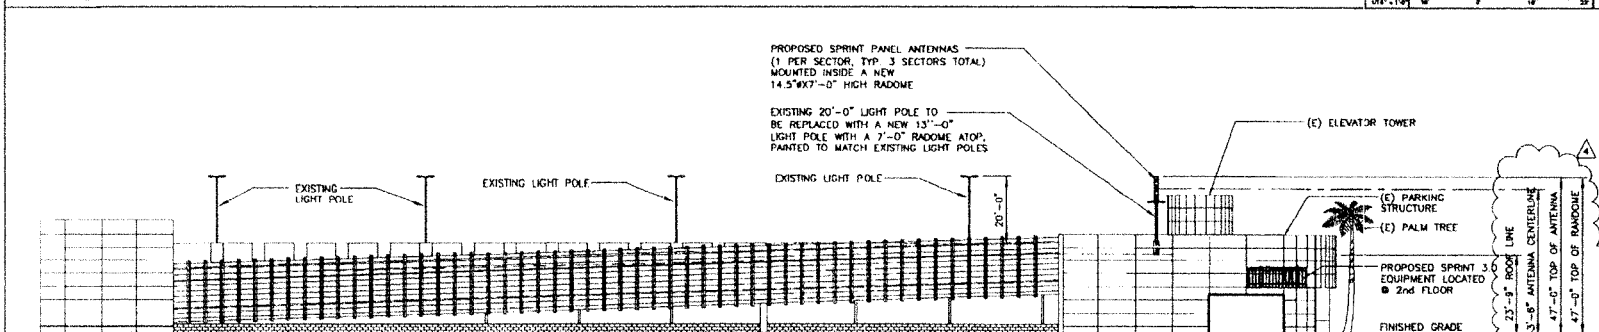


NORTH ELEVATION

SCALE: 1/8" = 1'-0"

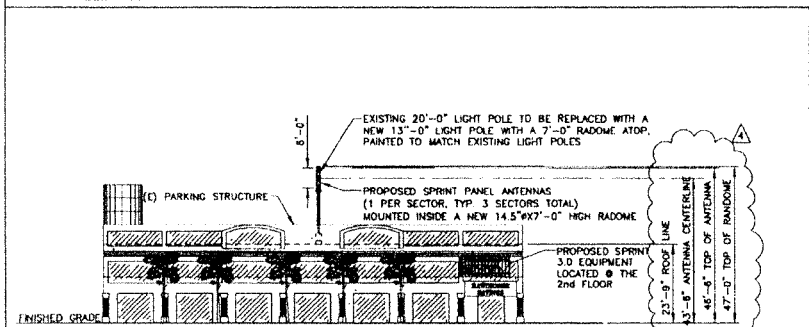

EAST ELEVATION

SCALE: 1/8" = 1'-0"

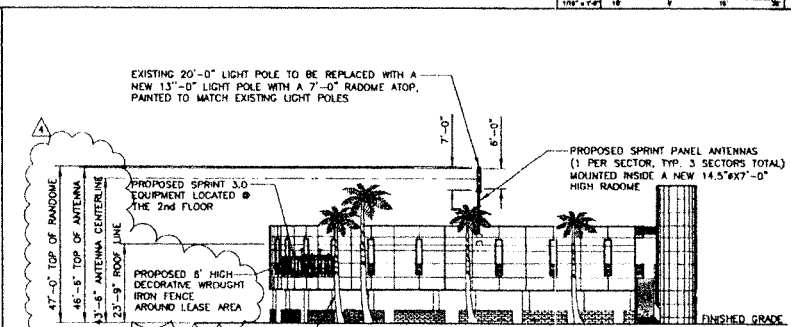

WEST ELEVATION

SCALE: 1/8" = 1'-0"



PROJECT INFORMATION
PACIFICCO
LA57XC302B
1301 HERMOSA AVE.
HERMOSA BEACH, CA 90254
LOS ANGELES COUNTY

CURRENT ISSUE DATE
10/3/2003

ISSUED FOR
PERMIT

REV. DATE ISSUED FOR

1	03/14/03	ISSUED FOR ZONING	JR
2	07/30/03	ISSUED FOR PERMIT	JR
3	08/14/03	PLAN CHECK CORRECTIONS	DW
4	10/3/03	PLAN CHECK CORRECTIONS	MR

PLANS PREPARED BY



CONSULTANT

DRAWN BY: CHK: APV: JR

LICENSURE

SHEET TITLE

ELEVATIONS

SHEET NUMBER: REVISION:

A3 4
103SP005



Exhibit A-3

[see attached]



ALL WORK AND MATERIALS SHALL BE PERFORMED AND INSTALLED IN ACCORDANCE WITH THE CURRENT EDITIONS OF THE FOLLOWING CODES AS ADOPTED BY THE LOCAL GOVERNING AUTHORITIES. NOTHING IN THESE PLANS IS TO BE CONSTRUCTED TO PERMIT WORK NOT CONFORMING TO THESE CODES.

1. 2016 CALIFORNIA ADMINISTRATIVE CODE
2. 2016 CALIFORNIA BUILDING CODE
3. 2016 CALIFORNIA ELECTRIC CODE
4. 2016 CALIFORNIA MECHANICAL CODE
5. 2016 CALIFORNIA PLUMBING CODE
6. 2016 CALIFORNIA FIRE CODE
7. ANY LOCAL BUILDING CODE AMENDMENTS TO THE ABOVE
8. CITY/COUNTY ORDINANCES

HANDICAP REQUIREMENTS:

FACILITY IS UNMANNED AND NOT FOR HUMAN HABITATION.
HANDICAPPED ACCESS NOT REQUIRED IN ACCORDANCE WITH CALIFORNIA ADMINISTRATIVE STATE CODE PART 2, TITLE 24, CHAPTER 11B, SECTION 1103B.

CODE COMPLIANCE

PROPERTY OWNER: THE CITY OF HERMOSA BEACH
CIVIC CENTER, 1315 VALLEY DRIVE
HERMOSA BEACH, CA. 90254
CONTACT: TOM BAKALY, CITY MANAGER
PHONE: (310) 318-0201

SITE ADDRESS: 1301 HERMOSA AVE
HERMOSA BEACH, CA 90255

GEOGRAPHIC COORDINATES: LATITUDE: 33.86280555 ° N (NAD 83)
LONGITUDE: -118.40133611° W (NAD 83)

APN: 4183-003-900

ZONING: C2 RESTRICTED COMMERCIAL

JURISDICTION: CITY OF HERMOSA BEACH

CONSTRUCTION TYPE: N/A

OCCUPANCY: N/A

CURRENT USE: TELECOMMUNICATIONS FACILITY

NEW USE: TELECOMMUNICATIONS FACILITY

NO. OF STORIES: 2

TRACT: TR 4183

BLOCK / LOT: 19, 20, 21, 22, 23, AND 32

LOT/PARCEL AREA: 19,361 (sq. ft.)

POWER COMPANY: SCE

TOP OF STRUCTURE: ±47'-0" (AGL)

GROUND ELEVATION: 14' AMSL

PROJECT INFORMATION

APPLICANT/LESSEE:
SPRINT
6591 IRVINE CENTER DRIVE
IRVINE, CA 92618
CONTACT: ANGLEEE HEFNY
PHONE: (949) 838-4317
EMAIL: anglee.hefny@sprint.com

ENGINEERING:
EUKON GROUP
630 S. GRAND AVE, SUITE 101
SANTA ANA, CA 92705
CONTACT: JEFF JACOBS
PHONE: (949) 525-5005
EMAIL: jeff.jacobs@eukongroup.com

SITE ACQUISITION:
EUKON GROUP
630 S. GRAND AVE, SUITE 101
SANTA ANA, CA 92705
CONTACT: GRANT MACY
PHONE: (626) 826-4419
EMAIL: grant@eukongroup.com

CONSTRUCTION MANAGER:
SPRINT
6591 IRVINE CENTER DRIVE
IRVINE, CA 92618
CONTACT: EUGENE HAIK
PHONE: (562) 240-3580
EMAIL: eugene.haik@sprint.com

RF ENGINEER:
SPRINT
6591 IRVINE CENTER DRIVE SUITE 100
IRVINE, CA 92618

PROJECT TEAM



PACIFICO
LA57XC302
1301 HERMOSA AVE
HERMOSA BEACH, CA 90255
(DO MACRO)

FROM: SPRINT OFFICE, 6591 IRVINE CENTER DR, IRVINE, CA


1. DEPART IRVINE CENTER DR TOWARD SAND CANYON AVE
2. TURN LEFT ONTO SAND CANYON AVE
3. TAKE RAMP RIGHT AND FOLLOW SIGNS FOR I-405 NORTH
4. KEEP LEFT TO STAY ON I-405 N
5. AT EXIT 40, TAKE RAMP RIGHT FOR CA-91 TOWARD CULTURAL ARTS COLLEGE / DEL AMO / HERMOSA BEACH / PRAIRIE AVE / REDONDO BEACH / TORRANCE
6. TURN LEFT ONTO CA-1 / PACIFIC COAST HWY
7. TURN RIGHT ONTO PIER AVE
8. TURN RIGHT ONTO MANHATTAN AVE
9. TURN LEFT ONTO 14TH ST
10. TURN LEFT ONTO HERMOSA AVE
11. DESTINATION WILL BE ON THE RIGHT
12. ARRIVE AT 1301 HERMOSA AVE, HERMOSA BEACH, CA 90254

DRIVING DIRECTIONS

SPRINT PROPOSES TO MODIFY AN EXISTING UNMANNED TELECOMMUNICATIONS FACILITY CONSISTING ON THE FOLLOWING:

- REMOVE (3) EXISTING SINGLE BAND ANTENNAS
- REMOVE EXISTING FRP CANISTER
- REMOVE EXISTING EQUIPMENT CABINET
- REMOVE EXISTING BATTERY CABINET
- INSTALL SCREEN BOX
- INSTALL (1) TRI-SECTOR ANTENNA
- INSTALL (3) 2.5 RRH
- INSTALL (6) 800 RRH
- INSTALL EQUIPMENT CABINET
- INSTALL BATTERY CABINET
- INSTALL NEW 8' HIGH CHAIN-LINK ENCLOSURE W/ TOPPER
- INSTALL NEW HYBRID CABLES

PROJECT DESCRIPTION

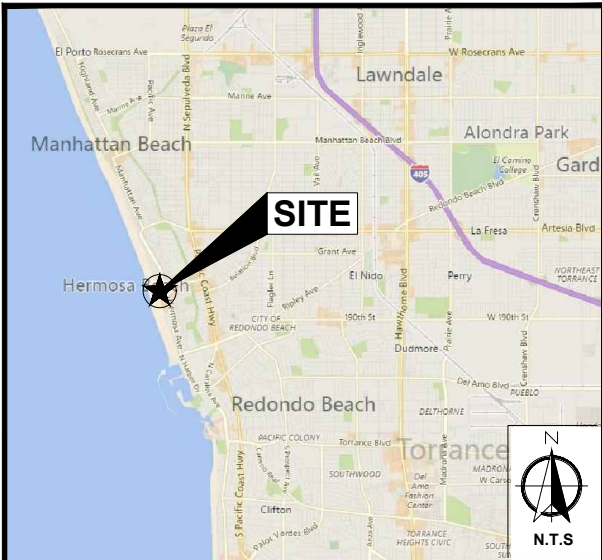

VICINITY MAP



AERIAL

CONSTRUCTION DRAWINGS

DO NOT SCALE DRAWING:

CONTRACTOR SHALL VERIFY ALL PLANS AND EXISTING DIMENSIONS AND CONDITIONS ON THE JOB SITE AND SHALL IMMEDIATELY NOTIFY THE ENGINEER IN WRITING OF ANY DISCREPANCIES BEFORE PROCEEDING WITH THE WORK OR BE RESPONSIBLE FOR SAME.

GENERAL CONTRACTOR NOTES

SHEET	DESCRIPTION	REV.
T-1	TITLE SHEET	3
T-2	GENERAL NOTES, ABBREVIATIONS AND LEGEND	3
T-3	GENERAL CONSTRUCTION NOTES	3
A-1	SITE PLAN	3
A-2	EXISTING ROOF PLAN	3
A-3	EXISTING EQUIPMENT LAYOUT	3
A-3.1	NEW EQUIPMENT LAYOUT	3
A-4	EXISTING AND NEW ANTENNA PLANS AND ANTENNA / RRH SCHEDULE	3
A-4.1	EXISTING AND NEW WEST ELEVATION	3
A-5	EQUIPMENT DETAILS	3
A-6	EQUIPMENT DETAILS	3
S-1	STRUCTURAL NOTES	3
S-2	SCREEN FRAMING PLAN	3
GN-1	GROUNDING DETAILS & SPECIFICATIONS	3
E-1	ONE-LINE DIAGRAM / GROUNDING DETAILS	3

SHEET INDEX

APPROVED BY:	INITIALS:	DATE:
LANDLORD: _____		
CONSTRUCTION MANAGER: _____		
RF ENGINEER: _____		
SITE ACQUISITION MANAGER: _____		
ZONING MANAGER: _____		
UTILITY COORDINATOR: _____		
PROGRAM REGIONAL MANAGER: _____		
NETWORK OPERATIONS MANAGER: _____		

APPROVALS

APPLICANT:



6591 IRVINE CENTER DRIVE SUITE 100
IRVINE, CA 92618

ENGINEER:



65 POST, SUITE 1000
IRVINE, CA 92618
TEL: (949) 553-8566
www.eukongroup.com

DRAWN BY: TC/EL/CB/JAR
CHECKED BY: JAR

REVISIONS:

REV	DATE	DESCRIPTION
3	01/10/19	DRM COMMENTS
2	08/19/19	PER SITE WALK
1	07/09/19	REDESIGN
0	12/13/17	100% CONSTRUCTION DRAWING
A	10/30/17	90% CONSTRUCTION DRAWING

LICENSER:



EXP. DATE: 12-31-21

DATE SIGNED: 10-23-18

PROJECT INFORMATION:

PACIFICO
LA57XC302

1301 HERMOSA AVE
HERMOSA BEACH, CA 90255

SHEET TITLE:

TITLE SHEET

SHEET NUMBER:

T-1

ABBREVIATIONS

GENERAL NOTES

SHEET NUMBER:
T-2

GENERAL CONSTRUCTION NOTES:

- GENERAL CONSTRUCTION
1. FOR THE PURPOSE OF CONSTRUCTION DRAWINGS, THE FOLLOWING DEFINITIONS SHALL APPLY:
GENERAL CONTRACTOR
CONTRACTOR: (CONSTRUCTION)
OWNER – VERIZON
2. ALL SITE WORK SHALL BE COMPLETED AS INDICATED ON THE DRAWINGS AND VERIZON PROJECT SPECIFICATIONS.
3. GENERAL CONTRACTOR SHALL VISIT THE SITE AND SHALL FAMILIARIZE HIMSELF WITH ALL CONDITIONS AFFECTING THE NEW WORK AND SHALL MAKE PROVISIONS. GENERAL CONTRACTOR SHALL BE RESPONSIBLE FOR FAMILIARIZING HIMSELF WITH ALL CONTRACT DOCUMENTS, FIELD CONDITIONS, DIMENSIONS, AND CONFIRMING THAT THE WORK MAY BE ACCOMPLISHED AS SHOWN PRIOR TO PROCEEDING WITH CONSTRUCTION. ANY DISCREPANCIES SHALL BE BROUGHT TO THE ATTENTION OF THE ENGINEER PRIOR TO THE COMMENCEMENT OF WORK.
4. ALL MATERIALS FURNISHED AND INSTALLED SHALL BE IN STRICT ACCORDANCE WITH ALL APPLICABLE CODES, REGULATIONS, AND ORDINANCES. GENERAL CONTRACTOR SHALL ISSUE ALL APPROPRIATE NOTICES AND COMPLY WITH ALL LAWS, ORDINANCES, RULES, REGULATIONS, AND LAWFUL ORDERS OF ANY PUBLIC AUTHORITY REGARDING THE PERFORMANCE OF WORK.
5. ALL WORK CARRIED OUT SHALL COMPLY WITH ALL APPLICABLE MUNICIPAL AND UTILITY COMPANY SPECIFICATIONS AND LOCAL JURISDICTIONAL CODES, ORDINANCES, AND APPLICABLE REGULATIONS.
6. UNLESS NOTED OTHERWISE, THE WORK SHALL INCLUDE FURNISHING MATERIALS, EQUIPMENT, APPURTENANCES, AND LABOR NECESSARY TO COMPLETE ALL INSTALLATIONS AS INDICATED ON THE DRAWINGS.
7. PLANS ARE NOT TO BE SCALED. THESE PLANS ARE INTENDED TO BE A DIAGRAMMATIC OUTLINE ONLY. UNLESS OTHERWISE NOTED, DIMENSIONS SHOWN ARE TO FINISH SURFACES UNLESS OTHERWISE NOTED. SPACING BETWEEN EQUIPMENT IS THE MINIMUM REQUIRED CLEARANCE. THEREFORE, IT IS CRITICAL TO FIELD VERIFY DIMENSIONS. SHOULD THERE BE ANY QUESTIONS REGARDING THE CONTRACT DOCUMENTS, THE CONTRACTOR SHALL BE RESPONSIBLE FOR OBTAINING A CLARIFICATION FROM THE ENGINEER PRIOR TO PROCEEDING WITH THE WORK. DETAILS ARE INTENDED TO SHOW DESIGN INTENT. MODIFICATIONS MAY BE REQUIRED TO SUIT JOB DIMENSIONS OR CONDITIONS AND SUCH MODIFICATIONS SHALL BE INCLUDED AS PART OF WORK AND PREPARED BY THE ENGINEER PRIOR TO PROCEEDING WITH WORK.
8. THE CONTRACTOR SHALL INSTALL ALL EQUIPMENT AND MATERIALS IN ACCORDANCE WITH MANUFACTURER'S RECOMMENDATIONS UNLESS SPECIFICALLY STATED OTHERWISE.
9. IF THE SPECIFIED EQUIPMENT CANNOT BE INSTALLED AS SHOWN ON THESE DRAWINGS, THE CONTRACTOR SHALL PROPOSE AN ALTERNATIVE INSTALLATION SPACE FOR APPROVAL BY THE ENGINEER PRIOR TO PROCEEDING.
10. GENERAL CONTRACTOR SHALL BE RESPONSIBLE FOR THE SAFETY OF WORK AREA, ADJACENT AREAS AND BUILDING OCCUPANTS THAT ARE LIKELY TO BE AFFECTED BY THE WORK UNDER THIS CONTRACT. WORK SHALL CONFIRM TO ALL OSHA REQUIREMENTS AND THE LOCAL JURISDICTION.
11. GENERAL CONTRACTOR SHALL COORDINATE WORK AND SCHEDULE WORK ACTIVITIES WITH OTHER DISCIPLINES.
12. ERECTION SHALL BE DONE IN A WORKMANLIKE MANNER BY COMPETENT EXPERIENCED WORKMAN IN ACCORDANCE WITH APPLICABLE CODES AND THE BEST ACCEPTED PRACTICE. ALL MEMBERS SHALL BE LAID PLUMB AND TRUE AS INDICATED ON THE DRAWINGS.
13. SEAL PENETRATIONS THROUGH FIRE RATED AREAS WITH UL LISTED MATERIALS APPROVED BY LOCAL JURISDICTION. CONTRACTOR SHALL KEEP AREA CLEAN, HAZARD FREE, AND DISPOSE OF ALL DEBRIS.
14. WORK PREVIOUSLY COMPLETED IS REPRESENTED BY LIGHT SHADED LINES AND NOTES. THE SCOPE OF WORK FOR THIS PROJECT IS REPRESENTED BY DARK SHADED LINES AND NOTES. CONTRACTOR SHALL NOTIFY THE GENERAL CONTRACTOR OF ANY EXISTING CONDITIONS THAT DEViate FROM THE DRAWINGS PRIOR TO BEGINNING CONSTRUCTION.
15. CONTRACTOR SHALL PROVIDE WRITTEN NOTICE TO THE CONSTRUCTION MANAGER 48 HOURS PRIOR TO COMMENCEMENT OF WORK.
16. THE CONTRACTOR SHALL PROTECT EXISTING IMPROVEMENTS, PAVEMENTS, CURBS, LANDSCAPING AND STRUCTURES. ANY DAMAGED PART SHALL BE REPAIRED AT CONTRACTOR'S EXPENSE TO THE SATISFACTION OF THE OWNER.
17. THE CONTRACTOR SHALL CONTACT UTILITY LOCATING SERVICES PRIOR TO THE START OF CONSTRUCTION.
18. GENERAL CONTRACTOR SHALL COORDINATE AND MAINTAIN ACCESS FOR ALL TRADES AND CONTRACTORS TO THE SITE AND/OR BUILDING.
19. THE GENERAL CONTRACTOR SHALL BE RESPONSIBLE FOR SECURITY OF THE SITE FOR THE DURATION OF CONSTRUCTION UNTIL JOB COMPLETION.
20. THE GENERAL CONTRACTOR SHALL MAINTAIN IN GOOD CONDITION ONE COMPLETE SET OF PLANS WITH ALL REVISIONS, ADDENDA, AND CHANGE ORDERS ON THE PREMISES AT ALL TIMES.
21. THE GENERAL CONTRACTOR SHALL PROVIDE PORTABLE FIRE EXTINGUISHERS WITH A RATING OF NOT LESS THAN 2-A OT 2-A:10-B-C AND SHALL BE WITHIN 25 FEET OF TRAVEL DISTANCE TO ALL PORTIONS OF WHERE THE WORK IS BEING COMPLETED DURING CONSTRUCTION.
22. ALL EXISTING ACTIVE SEWER, WATER, GAS, ELECTRIC, AND OTHER UTILITIES SHALL BE PROTECTED AT ALL TIMES, AND WHERE REQUIRED FOR THE PROPER EXECUTION OF THE WORK, SHALL BE RELOCATED AS DIRECTED BY THE ENGINEER. EXTREME CAUTION SHOULD BE USED BY THE CONTRACTOR WHEN EXCAVATING OR DRILLING PIERS AROUND OR NEAR UTILITIES. CONTRACTOR SHALL PROVIDE SAFETY TRAINING FOR THE WORKING CREW. THIS SHALL INCLUDE BUT NOT BE LIMITED TO A) FALL PROTECTION, B) CONFINED SPACE, C) ELECTRICAL SAFETY, AND D) TRENCHING & EXCAVATION.
23. ALL EXISTING INACTIVE SEWER, WATER, GAS, ELECTRIC, AND OTHER UTILITIES, WHICH INTERFERE WITH THE EXECUTION OF THE WORK, SHALL BE REMOVED, CAPPED, PLUGGED OR OTHERWISE DISCONNECTED AT POINTS WHICH WILL NOT INTERFERE WITH THE EXECUTION OF THE WORK, AS DIRECTED BY THE RESPONSIBLE ENGINEER, AND SUBJECT TO THE APPROVAL OF THE OWNER AND/OR LOCAL UTILITIES.
24. THE AREAS OF THE OWNER'S PROPERTY DISTURBED BY THE WORK AND NOT COVERED BY THE TOWER, EQUIPMENT OR DRIVEWAY, SHALL BE GRADED TO A UNIFORM SLOPE, AND STABILIZED TO PREVENT EROSION.
25. CONTRACTOR SHALL MINIMIZE DISTURBANCE TO THE EXISTING SITE DURING CONSTRUCTION. EROSION CONTROL MEASURES, IF REQUIRED DURING CONSTRUCTION, SHALL BE IN CONFORMANCE WITH THE FEDERAL AND LOCAL JURISDICTION FOR EROSION AND SEDIMENT CONTROL.
26. NO FILL OR EMBANKMENT MATERIAL SHALL BE PLACED ON FROZEN GROUNDING. FROZEN MATERIALS, SNOW OR ICE SHALL NOT BE PLACED IN ANY FILL OR EMBANKMENT.
27. THE SUBGRADE SHALL BE BROUGHT TO A SMOOTH UNIFORM GRADE AND COMPACTED TO 95 PERCENT STANDARD PROCTOR DENSITY UNDER PAVEMENT AND STRUCTURES AND 80 PERCENT STANDARD PROCTOR DENSITY IN OPEN SPACE. ALL TRENCHES IN PUBLIC RIGHT OF WAY SHALL BE BACKFILLED WITH FLOWABLE FILL OR OTHER MATERIAL PRE-APPROVED BY THE LOCAL JURISDICTION.
28. ALL NECESSARY RUBBISH, STUMPS, DEBRIS, STICKS, STONES, AND OTHER REFUSE SHALL BE REMOVED FROM THE SITE AND DISPOSED OF IN A LAWFUL MANNER.
29. ALL BROCHURES, OPERATING AND MAINTENANCE MANUALS, CATALOGS, SHOP DRAWINGS, AND OTHER DOCUMENTS SHALL BE TURNED OVER TO THE GENERAL CONTRACTOR AT COMPLETION OF CONSTRUCTION AND PRIOR TO PAYMENT.
30. CONTRACTOR SHALL SUBMIT A COMPLETE SET OF AS-BUILT REDLINES TO THE GENERAL CONTRACTOR UPON COMPLETION OF PROJECT AND PRIOR TO FINAL PAYMENT.

31. CONTRACTOR SHALL LEAVE PREMISES IN A CLEAN CONDITION.
32. THE NEW FACILITY WILL BE UNMANNED AND DOES NOT REQUIRE POTABLE WATER OR SEWER SERVICE, AND IS NOT FOR HUMAN HABITAT (NO HANDICAP ACCESS REQUIRED).
33. OCCUPANCY IS LIMITED TO PERIODIC MAINTENANCE AND INSPECTION, APPROXIMATELY 2 TIMES PER MONTH, BY VERIZON TECHNICIANS.
34. NO OUTDOOR STORAGE OR SOLID WASTE CONTAINERS ARE NEW.
35. ALL MATERIAL SHALL BE FURNISHED AND WORK SHALL BE PERFORMED IN ACCORDANCE WITH THE LATEST REVISION VERIZON MOBILITY GROUNDING STANDARD "TECHNICAL SPECIFICATION FOR CONSTRUCTION OF GSM/GPRS WIRELESS SITES" AND "TECHNICAL SPECIFICATION FOR FACILITY GROUNDING", IN CASE OF A CONFLICT BETWEEN THE CONSTRUCTION SPECIFICATION AND THE DRAWINGS, THE DRAWINGS SHALL GOVERN.
36. CONTRACTORS SHALL BE RESPONSIBLE FOR OBTAINING ALL PERMITS AND INSPECTIONS REQUIRED FOR CONSTRUCTION. IF CONTRACTOR CANNOT OBTAIN A PERMIT, THEY MUST NOTIFY THE GENERAL CONTRACTOR IMMEDIATELY.
37. CONTRACTOR SHALL REMOVE ALL TRASH AND DEBRIS FROM THE SITE ON A DAILY BASIS.
38. INFORMATION SHOWN ON THESE DRAWINGS WAS OBTAINED FROM SITE VISITS AND/OR DRAWINGS PROVIDED BY THE SITE OWNER. CONTRACTORS SHALL NOTIFY THE ENGINEER OF ANY DISCREPANCIES PRIOR TO ORDERING MATERIAL OR PROCEEDING WITH CONSTRUCTION.
39. NO WHITE STROBE LIGHTS ARE PERMITTED. LIGHTING IF REQUIRED, WILL MEET FAA STANDARDS AND REQUIREMENTS.
40. ALL COAXIAL CABLE INSTALLATIONS TO FOLLOW MANUFACTURER'S INSTRUCTIONS AND RECOMMENDATIONS.

ANTENNA MOUNTING

41. DESIGN AND CONSTRUCTION OF ANTENNA SUPPORTS SHALL CONFORM TO CURRENT ANSI/TIA-222 OR APPLICABLE LOCAL CODES.
42. ALL STEEL MATERIALS SHALL BE GALVANIZED AFTER FABRICATION IN ACCORDANCE WITH ASTM A123 "ZINC (HOT-DIP GALVANIZED) COATINGS ON IRON AND STEEL PRODUCTS", UNLESS NOTED OTHERWISE.
43. ALL BOLTS, ANCHORS AND MISCELLANEOUS HARDWARE SHALL BE GALVANIZED IN ACCORDANCE WITH ASTM A153 "ZINC-COATING (HOT-DIP) ON IRON AND STEEL HARDWARE", UNLESS NOTED OTHERWISE.
44. DAMAGED GALVANIZED SURFACES SHALL BE REPAIRED BY COLD GALVANIZING IN ACCORDANCE WITH ASTM A780.
45. ALL ANTENNA MOUNTS SHALL BE INSTALLED WITH LOCK NUTS, DOUBLE NUTS AND SHALL BE TORQUED TO MANUFACTURER'S RECOMMENDATIONS.
46. CONTRACTOR SHALL INSTALL ANTENNA PER MANUFACTURER'S RECOMMENDATION FOR INSTALLATION AND GROUNDING.
47. ALL UNUSED PORTS ON ANY ANTENNAS SHALL BE TERMINATED WITH A 50-OHM LOAD TO ENSURE ANTENNAS PERFORM AS DESIGNED.
48. PRIOR TO SETTING ANTENNA AZIMUTHS AND DOWNTILTS, ANTENNA CONTRACTOR SHALL CHECK THE ANTENNA MOUNT FOR TIGHTNESS AND ENSURE THAT THEY ARE PLUMB. ANTENNA AZIMUTHS SHALL BE SET FROM TRUE NORTH AND BE ORIENTED WITHIN +/- 5% AS DEFINED BY THE RFDS. ANTENNA DOWNTILTS SHALL BE WITHIN +/- 0.5% AS DEFINED BY THE RFDS. REFER TO ND-00246.
49. JUMPERS FROM THE TMA'S MUST TERMINATE TO OPPOSITE POLARIZATION'S IN EACH SECTOR.
50. CONTRACTOR SHALL RECORD THE SERIAL #, SECTOR, AND POSITION OF EACH ACTUATOR INSTALLED AT THE ANTENNAS AND PROVIDE THE INFORMATION TO VERIZON.
51. TMA'S SHALL BE MOUNTED ON PIPE DIRECTLY BEHIND ANTENNAS AS CLOSE TO ANTENNA AS FEASIBLE IN A VERTICAL POSITION.
52. ANTENNAS SHALL HAVE A 4'-0" MIN CENTER TO CENTER HORIZONTAL SEPARATION.

TORQUE REQUIREMENTS

53. ALL RF CONNECTIONS SHALL BE TIGHTENED BY A TORQUE WRENCH.
54. ALL RF CONNECTIONS, GROUNDING HARDWARE AND ANTENNA HARDWARE SHALL HAVE A TORQUE MARK INSTALLED IN A CONTINUOUS STRAIGHT LINE FROM BOTH SIDES OF THE CONNECTION.
A. RF CONNECTION BOTH SIDES OF THE CONNECTOR.
B. GROUNDING AND ANTENNA HARDWARE ON THE NUT SIDE STARTING FROM THE THREADS TO THE SOLID SURFACE. EXAMPLE OF SOLID SURFACE: GROUND BAR, ANTENNA BRACKET METAL.
55. ALL 8M ANTENNA HARDWARE SHALL BE TIGHTENED TO 9 LB-FT (12 NM).
56. ALL 12M ANTENNA HARDWARE SHALL BE TIGHTENED TO 43 LB-FT (58 NM).
57. ALL GROUNDING HARDWARE SHALL BE TIGHTENED UNTIL THE LOCK WASHER COLLAPSES AND THE GROUNDING HARDWARE IS NO LONGER LOOSE.
58. ALL DIN TYPE CONNECTIONS SHALL BE TIGHTENED TO 18-22 LB-FT (24.4 - 29.8 NM).
59. ALL N TYPE CONNECTIONS SHALL BE TIGHTENED TO 15-20 LB-IN (1.7 - 2.3 NM).

FIBER & POWER CABLE MOUNTING

60. THE FIBER OPTIC TRUNK CABLES SHALL BE INSTALLED INTO CONDUITS, CHANNEL CABLE TRAYS, OR CABLE TRAY. WHEN INSTALLING FIBER OPTIC TRUNK CABLES INTO A CABLE TRAY SYSTEM, THEY SHALL BE INSTALLED INTO AN INTER DUCT AND A PARTITION BARRIER SHALL BE INSTALLED BETWEEN THE 600 VOLT CABLES AND THE INTER DUCT IN ORDER TO SEGREGATE CABLE TYPES. OPTIC FIBER TRUNK CABLES SHALL HAVE APPROVED CABLE RESTRAINTS EVERY (60) SIXTY FEET AND SECURELY FASTENED TO THE CABLE TRAY SYSTEM. NFPA 70 (NEC) ARTICLE 770 RULES SHALL APPLY.
61. THE TYPE TC-ER CABLES SHALL BE INSTALLED INTO CONDUITS, CHANNEL CABLE TRAYS, OR CABLE TRAY AND SHALL BE SECURED AT INTERVALS NOT EXCEEDING (6) SIX FEET. AN EXCEPTION: WHERE TYPE TC-ER CABLES ARE NOT SUBJECT TO PHYSICAL DAMAGE, CABLES SHALL BE PERMITTED TO MAKE A TRANSITION BETWEEN CONDUITS, CHANNEL CABLE TRAYS, OR CABLE TRAY WHICH ARE SERVING UTILIZATION EQUIPMENT OR DEVICES, A DISTANCE (6) SIX FEET SHALL NOT BE EXCEEDED WITHOUT CONTINUOUS SUPPORTING. NFPA 70 (NEC) ARTICLES 336 AND 392 RULES SHALL APPLY.
62. WHEN INSTALLING OPTIC FIBER TRUNK CABLES OR TYPE TC-ER CABLES INTO CONDUITS, NFPA 70 (NEC) ARTICLE 300 RULES SHALL APPLY.

COAXIAL CABLE NOTES

63. TYPES AND SIZES OF THE ANTENNA CABLE ARE BASED ON ESTIMATED LENGTHS. PRIOR TO ORDERING CABLE, CONTRACTOR SHALL VERIFY ACTUAL LENGTH BASED ON CONSTRUCTION LAYOUT AND NOTIFY THE PROJECT MANAGER IF ACTUAL LENGTHS EXCEED ESTIMATED LENGTHS.
62. CONTRACTOR SHALL VERIFY THE DOWN-TILT OF EACH ANTENNA WITH A DIGITAL LEVEL.
63. CONTRACTOR SHALL CONFIRM COAX COLOR CODING PRIOR TO CONSTRUCTION. REFER TO "ANTENNA SYSTEM LABELING STANDARD" ND-00027 LATEST VERSION.
64. ALL JUMPERS TO THE ANTENNAS FROM THE MAIN TRANSMISSION LINE SHALL BE 1/2" DIA. LDF AND SHALL NOT EXCEED 6'-0".
65. ALL COAXIAL CABLE SHALL BE SECURED TO THE DESIGNED SUPPORT STRUCTURE, IN AN APPROVED MANNER, AT DISTANCES NOT TO EXCEED 4'-0" OC.
66. CONTRACTOR SHALL FOLLOW ALL MANUFACTURER'S RECOMMENDATIONS REGARDING BOTH THE INSTALLATION AND GROUNDING OF ALL COAXIAL CABLES, CONNECTORS, ANTENNAS, AND ALL OTHER EQUIPMENT.
67. CONTRACTOR SHALL WEATHERPROOF ALL ANTENNA CONNECTORS WITH SELF AMALGAMATING TAPE. WEATHERPROOFING SHALL BE COMPLETED IN STRICT ACCORDANCE WITH VERIZON STANDARDS.
68. CONTRACTOR SHALL BE RESPONSIBLE TO VERIFY ANTENNA, TMAS, DIPLEXERS, AND COAX CONFIGURATION, MAKE AND MODELS PRIOR TO INSTALLATION.
69. ALL CONNECTIONS FOR HANGERS, SUPPORTS, BRACING, ETC. SHALL BE INSTALLED PER TOWER MANUFACTURER'S RECOMMENDATIONS.
70. CONTRACTOR SHALL REFERENCE THE TOWER STRUCTURAL ANALYSIS/DESIGN DRAWINGS FOR DIRECTIONS ON CABLE DISTRIBUTION/ROUTING.
71. ALL OUTDOOR RF CONNECTORS/CONNECTIONS SHALL BE WEATHERPROOFED, EXCEPT THE RET CONNECTORS. USING BUTYL TAPE AFTER INSTALLATION AND FINAL CONNECTIONS ARE MADE. BUTYL TAPE SHALL HAVE A MINIMUM OF ONE-HALF TAPE WIDTH OVERLAP ON EACH TURN AND EACH LAYER SHALL BE WRAPPED THREE TIMES. WEATHERPROOFING SHALL BE SMOOTH WITHOUT BUCKLING. BUTYL BLEEDING IS NOT ALLOWED.
72. IF REQUIRED TO PAINT ANTENNAS AND/OR COAX:
A. TEMPERATURE SHALL BE ABOVE 50° F.
B. PAINT COLOR MUST BE APPROVED BY BUILDING OWNER/LANDLORD.
C. FOR REGULATED TOWERS, FAA/FCC APPROVED PAINT IS REQUIRED.
D. DO NOT PAINT OVER COLOR CODING OR ON EQUIPMENT MODEL NUMBERS.
73. ALL CABLES SHALL BE GROUNDED WITH COAXIAL CABLE GROUND KITS. FOLLOW THE MANUFACTURER'S RECOMMENDATIONS.
A. GROUNDING AT THE ANTENNA LEVEL.
B. GROUNDING AT MID LEVEL, TOWERS WHICH ARE OVER 200'-0", ADDITIONAL CABLE GROUNDING REQUIRED.
C. GROUNDING AT BASE OF TOWER PRIOR TO TURNING HORIZONTAL.
D. GROUNDING OUTSIDE THE EQUIPMENT SHELTER AT ENTRY PORT.
E. GROUNDING INSIDE THE EQUIPMENT SHELTER AT THE ENTRY PORT.
74. ALL NEW GROUND BAR DOWNLEADS ARE TO BE TERMINATED TO THE EXISTING ADJACENT GROUND BAR DOWNLEADS A MINIMUM DISTANCE OF 4'-0" BELOW GROUND BAR. TERMINATIONS MAY BE EXOTHERMIC OR COMPRESSION.
75. THE CONTRACTOR SHALL BE RESPONSIBLE FOR VERIFYING THE ANTENNA AND THE COAX CONFIGURATION IS THE CORRECT MAKE AND MODELS, PRIOR TO INSTALLATION.
76. ALL CONNECTIONS FOR HANGERS, SUPPORTS, BRACING, ETC. SHALL BE INSTALLED PER TOWER MANUFACTURER'S SPECIFICATION & RECOMMENDATIONS.
77. ANTENNA CONTRACTOR SHALL FURNISH AND INSTALL A 12'-0" T-BOOM SECTOR ANTENNA MOUNT, IF APPLICABLE, INCLUDING ALL HARDWARE.

STATEMENT OF SPECIAL INSPECTIONS

NO.	DESCRIPTION OF TYPE OF INSPECTION REQUIRED LOCATION, REMARKS,	FREQUENCY
1.	POST INSTALLED CONCRETE ANCHORS: (SEE SHEET A-5, DETAIL 7)	
	ADHESIVE AND EXPANSION ANCHORS IN CONCRETE OR MASONRY, HILTI KWIK BOLT TZ EXPANSION ANCHOR, PER ICC REPORT ESR-1917	PERIODIC
	ADHESIVE AND EXPANSION ANCHORS IN CONCRETE OR MASONRY, INSPECTOR SHALL VERIFY ANCHOR TYPE, ANCHOR DIMENSIONS,	
	CONCRETE TYPE, THICKNESS AND COMPRESSIVE STRENGTH, HOLED DIMENSIONS, HOLE CLEANING PROCEDURES, ANCHOR SPACING,	
	EDGE DISTANCES, ANCHOR EMBEDMENT, AND TIGHTENING TORQUE.	

SPECIAL INSPECTION NOTES:
1. THE SPECIAL INSPECTIONS IDENTIFIED ON PLANS ARE, IN ADDITION TO, AND NOT A SUBSTITUTE FOR, THOSE INSPECTIONS REQUIRED TO BE PERFORMED BY A CITY'S BUILDING INSPECTOR.

2. CONTINUOUS INSPECTION IS ALWAYS REQUIRED DURING THE PERFORMANCE OF THE WORK UNLESS OTHERWISE SPECIFIED. WHEN WORK IN MORE THAN ONE CATEGORY OF WORK REQUIRING SPECIAL INSPECTION IS TO BE PERFORMED SIMULTANEOUSLY, OR THE GEOGRAPHIC LOCATION OF THE WORK IS SUCH THAT IT CANNOT BE CONTINUOUSLY OBSERVED IN ACCORDANCE WITH THE PROVISIONS OF CBC SECTION 1704, IT IS THE AGENT'S RESPONSIBILITY TO EMPLOY A SUFFICIENT NUMBER OF INSPECTORS TO ASSURE THAT ALL THE WORK IS INSPECTED IN ACCORDANCE WITH THOSE PROVISIONS.

3. THE SPECIAL INSPECTORS MUST BE CERTIFIED BY THE **AUTHORITY HAVING JURISDICTION**, IN THE CATEGORY OF WORK REQUIRED TO HAVE SPECIAL INSPECTION.

4. IT IS THE RESPONSIBILITY OF THE CONTRACTOR TO NOTIFY THE SPECIAL INSPECTOR OR INSPECTION AGENCY AT LEAST ONE WORKING DAY PRIOR TO PERFORMING ANY WORK THAT REQUIRES SPECIAL INSPECTION.

5. NOTICE TO THE CONTRACTOR/BUILDER/INSTALLER/SUB-CONTRACTOR/ OWNER-BUILDER: BY USING THIS PERMITTED CONSTRUCTION DRAWINGS FOR CONSTRUCTION/INSTALLATION OF THE WORK SPECIFIED HEREIN, YOU ACKNOWLEDGE AND ARE AWARE OF, THE REQUIREMENTS CONTAINED IN THE STATEMENT OF SPECIAL INSPECTIONS. YOU AGREE TO COMPLY WITH THE REQUIREMENTS OF THE AUTHORITY HAVING JURISDICTION FOR SPECIAL INSPECTIONS, STRUCTURAL OBSERVATIONS, CONSTRUCTION MATERIAL TESTING AND OFF-SITE FABRICATION OF BUILDING COMPONENTS, CONTAINED IN THE STATEMENT OF SPECIAL INSPECTIONS AND, AS REQUIRED BY THE CALIFORNIA CONSTRUCTION CODES.

6. THE CONSTRUCTION MATERIALS TESTING LABORATORY MUST BE APPROVED BY THE AUTHORITY HAVING JURISDICTION, FOR TESTING OF MATERIALS, SYSTEMS, COMPONENTS AND, EQUIPMENTS.

7. WORK REQUIRING SPECIAL INSPECTION THAT IS INSTALLED OR COVERED WITHOUT THE APPROVAL OF THE CITY INSPECTOR IS SUBJECT TO REMOVAL OR EXPOSURE AT NO COST TO THE GOVERNING JURISDICTION.

8. FABRICATOR MUST BE REGISTERED AND APPROVED BY THE AUTHORITY HAVING JURISDICTION FOR THE FABRICATION OF MEMBERS AND ASSEMBLIES ON THE PREMISES OF THE FABRICATOR'S SHOP.

APPLICANT:



6591 IRVINE CENTER DRIVE SUITE 100
IRVINE, CA 92618

ENGINEER:


an SFC Communications, Inc. Company

65 POST, SUITE 1000
IRVINE, CA 92618
TEL: (949) 553-8566
www.eukongroup.com

DRAWN BY: TC/EL/CB/JAR

CHECKED BY: JAR

REVISIONS:		
3	01/10/19	DRM COMMENTS
2	08/19/19	PER SITE WALK
1	07/09/19	REDESIGN
0	12/13/17	100% CONSTRUCTION DRAWING
A	10/30/17	90% CONSTRUCTION DRAWING
REV	DATE	DESCRIPTION

LICENSER:



EXP. DATE: 12-31-21

DATE SIGNED: 10-23-18

PROJECT INFORMATION:

PACIFICO

LA57XC302

1301 HERMOSA AVE
HERMOSA BEACH, CA 90255


SHEET TITLE:

GENERAL CONSTRUCTION NOTES &
SPECIAL INSPECTIONS

SHEET NUMBER:

T-3

SCALE NOTE:
IF DIMENSIONS SHOWN ON PLAN DO NOT SCALE CORRECTLY, CHECK FOR REDUCTION OR ENLARGEMENT FROM ORIGINAL PLANS.

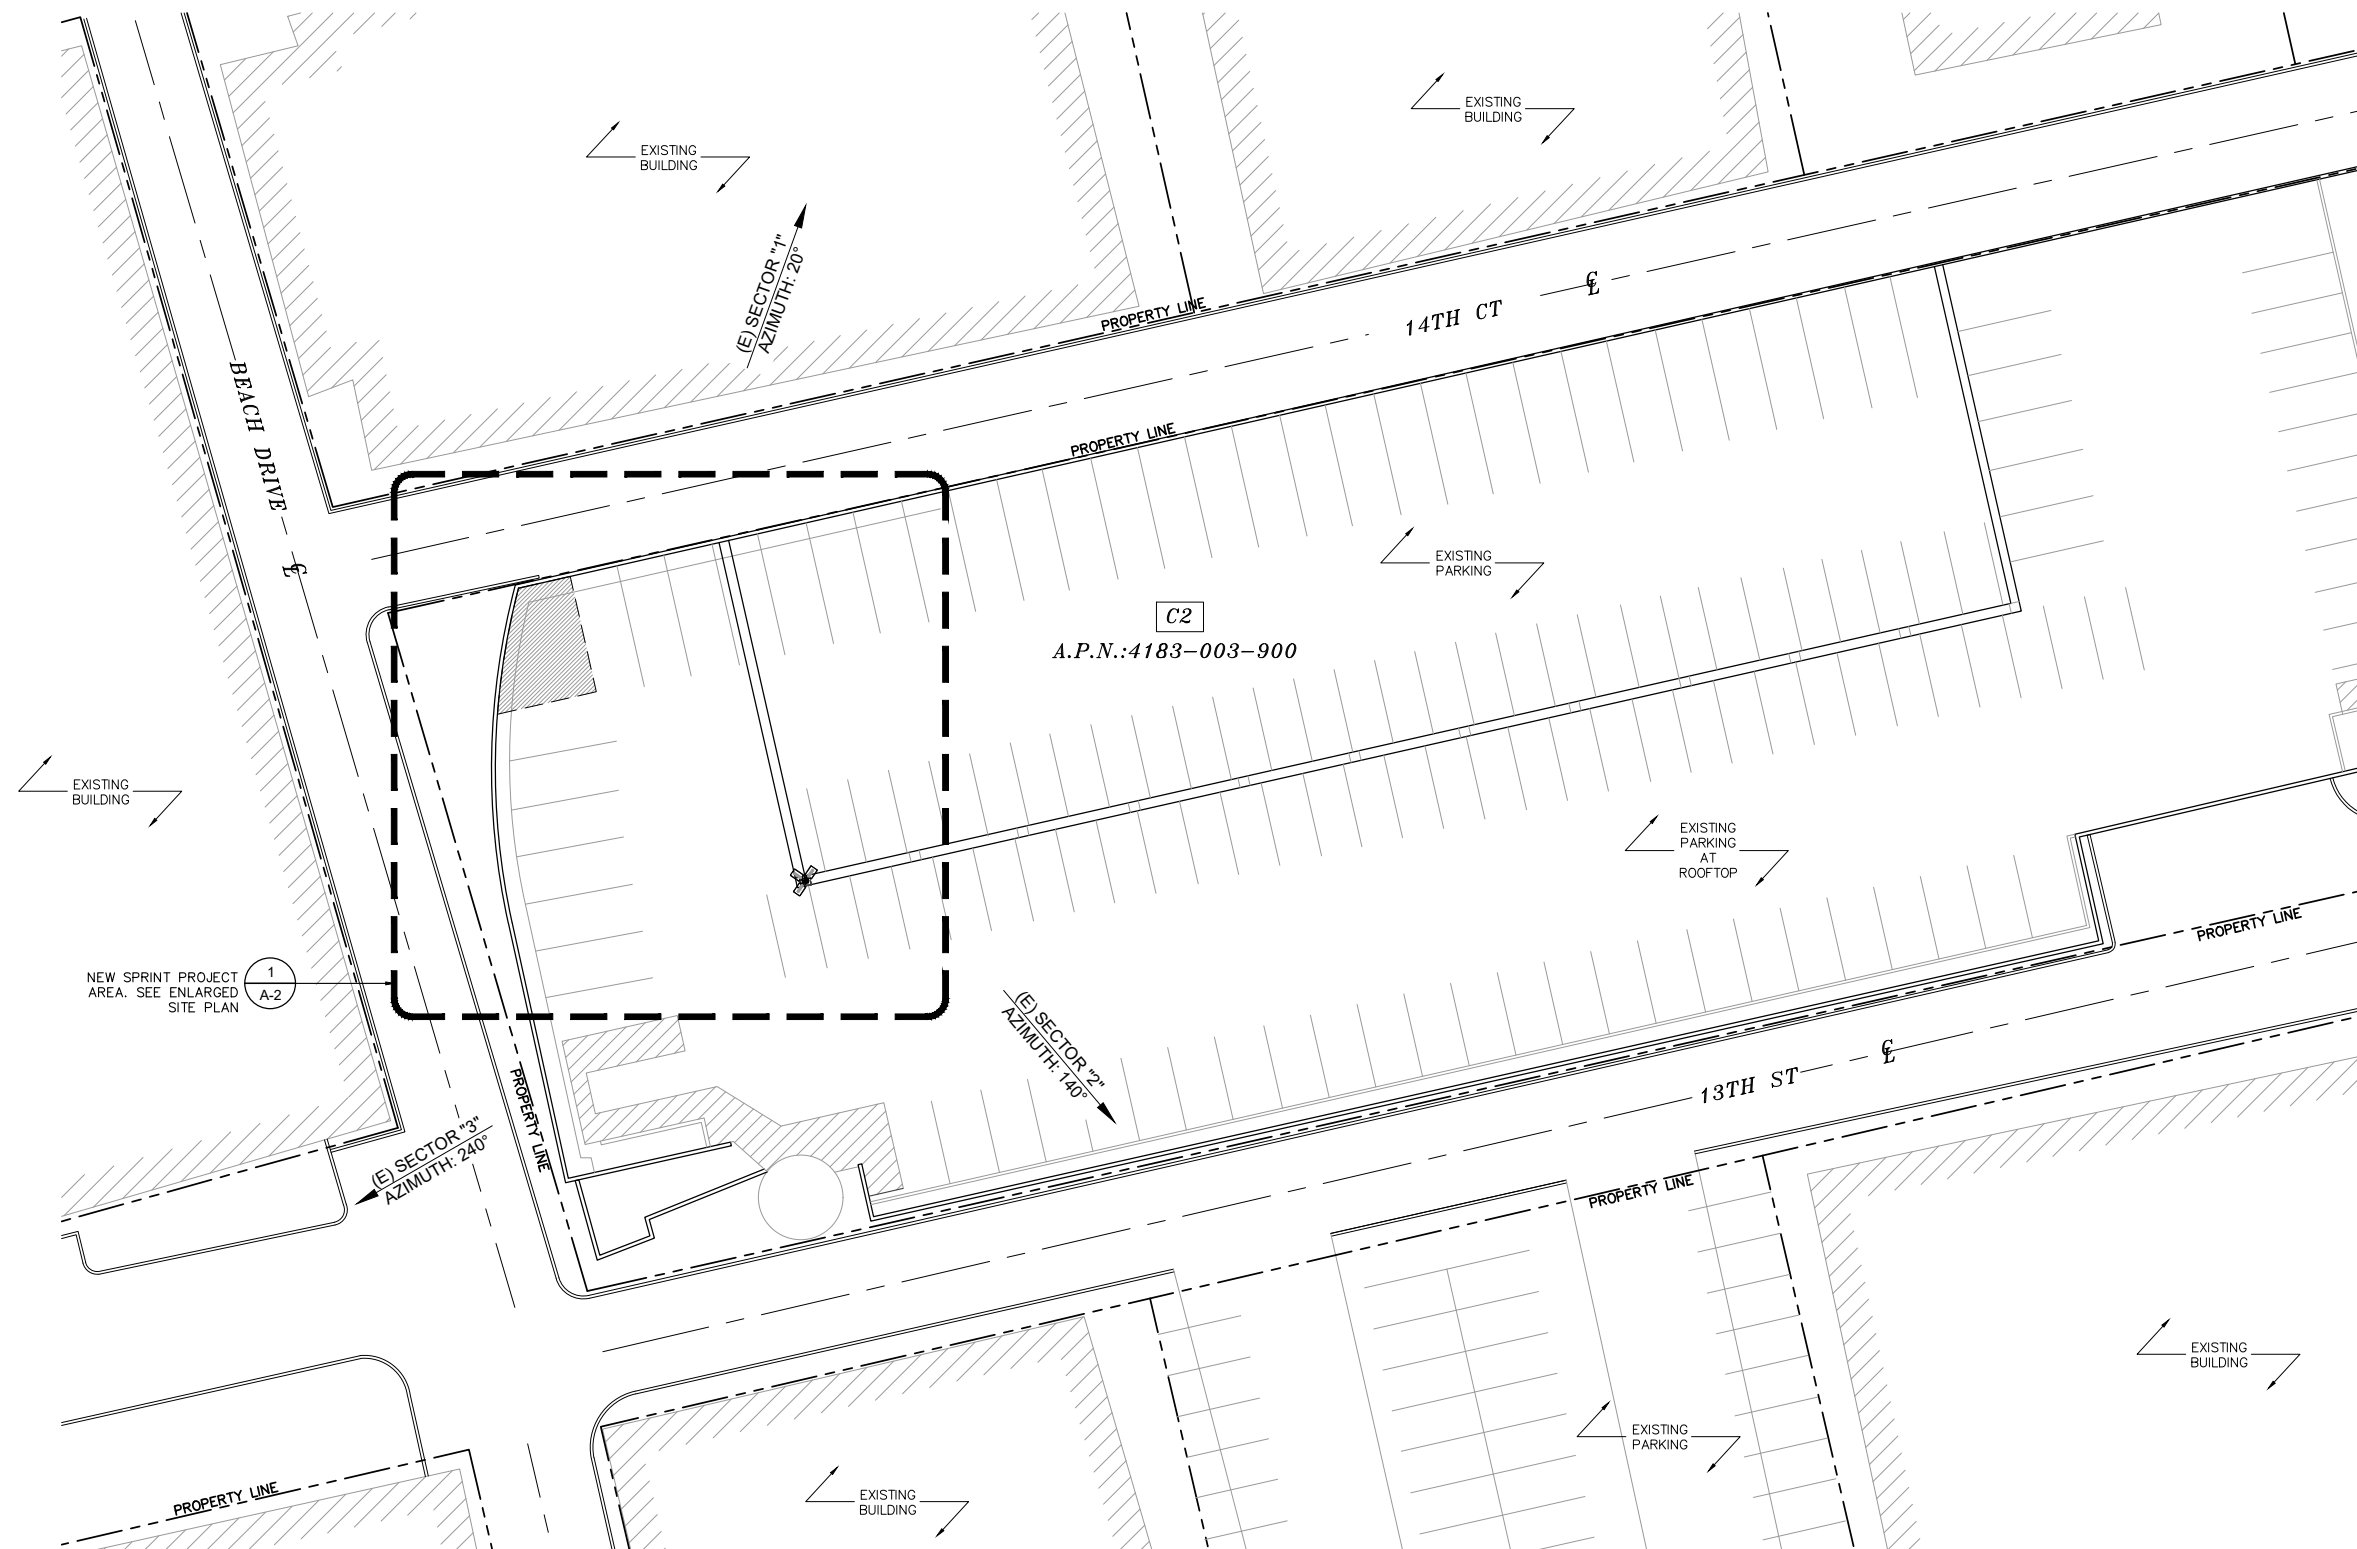

BUILDING DEPARTMENT NOTES:

1. THE CONSTRUCTION SHALL NOT RESTRICT A FIVE-FOOT CLEAR AND UNOBSTRUCTED ACCESS TO ANY WATER OR POWER DISTRIBUTION FACILITIES (POWER POLES, PULL BOXES, TRANSFORMERS, VAULTS, PUMPS, VALVES, METERS, APPURTENANCES, ETC.) OR TO THE LOCATION OF THE HOOK-UP. THE CONSTRUCTION SHALL NOT BE WITHIN TEN FEET OF ANY POWER LINES—WHETHER OR NOT THE LINES ARE LOCATED ON THE PROPERTY. FAILURE TO COMPLY MAY CAUSE CONSTRUCTION DELAYS AND/OR ADDITIONAL EXPENSES.

SITE PLAN

APPLICANT:



6591 IRVINE CENTER DRIVE SUITE 100
IRVINE, CA 92618

ENGINEER:



Eukon
an SFC Communications, Inc. Company

65 POST, SUITE 1000
IRVINE, CA 92618
TEL: (949) 553-8566
www.eukongroup.com

DRAWN BY:	TC/EL/CB/JAR
CHECKED BY:	JAR

REVISIONS:

3	01/10/19	DRM COMMENTS
2	08/19/19	PER SITE WALK
1	07/09/19	REDESIGN
0	12/13/17	100% CONSTRUCTION DRAWING
A	10/30/17	90% CONSTRUCTION DRAWING
REV	DATE	DESCRIPTION

LICENSER:



EXP. DATE: 12-31-21

DATE SIGNED: 10-23-18

PROJECT INFORMATION:

PACIFICO

LA57XC302


1301 HERMOSA AVE
HERMOSA BEACH, CA 90255

SHEET TITLE:


SITE PLAN

SHEET NUMBER:

A-1

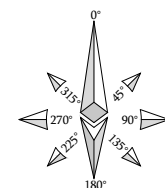


SCALE
1/16"=1'-0"

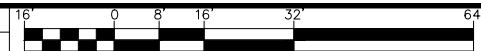

1

SCALE NOTE:
IF DIMENSIONS SHOWN ON PLAN DO
NOT SCALE CORRECTLY, CHECK FOR
REDUCTION OR ENLARGEMENT FROM
ORIGINAL PLANS.

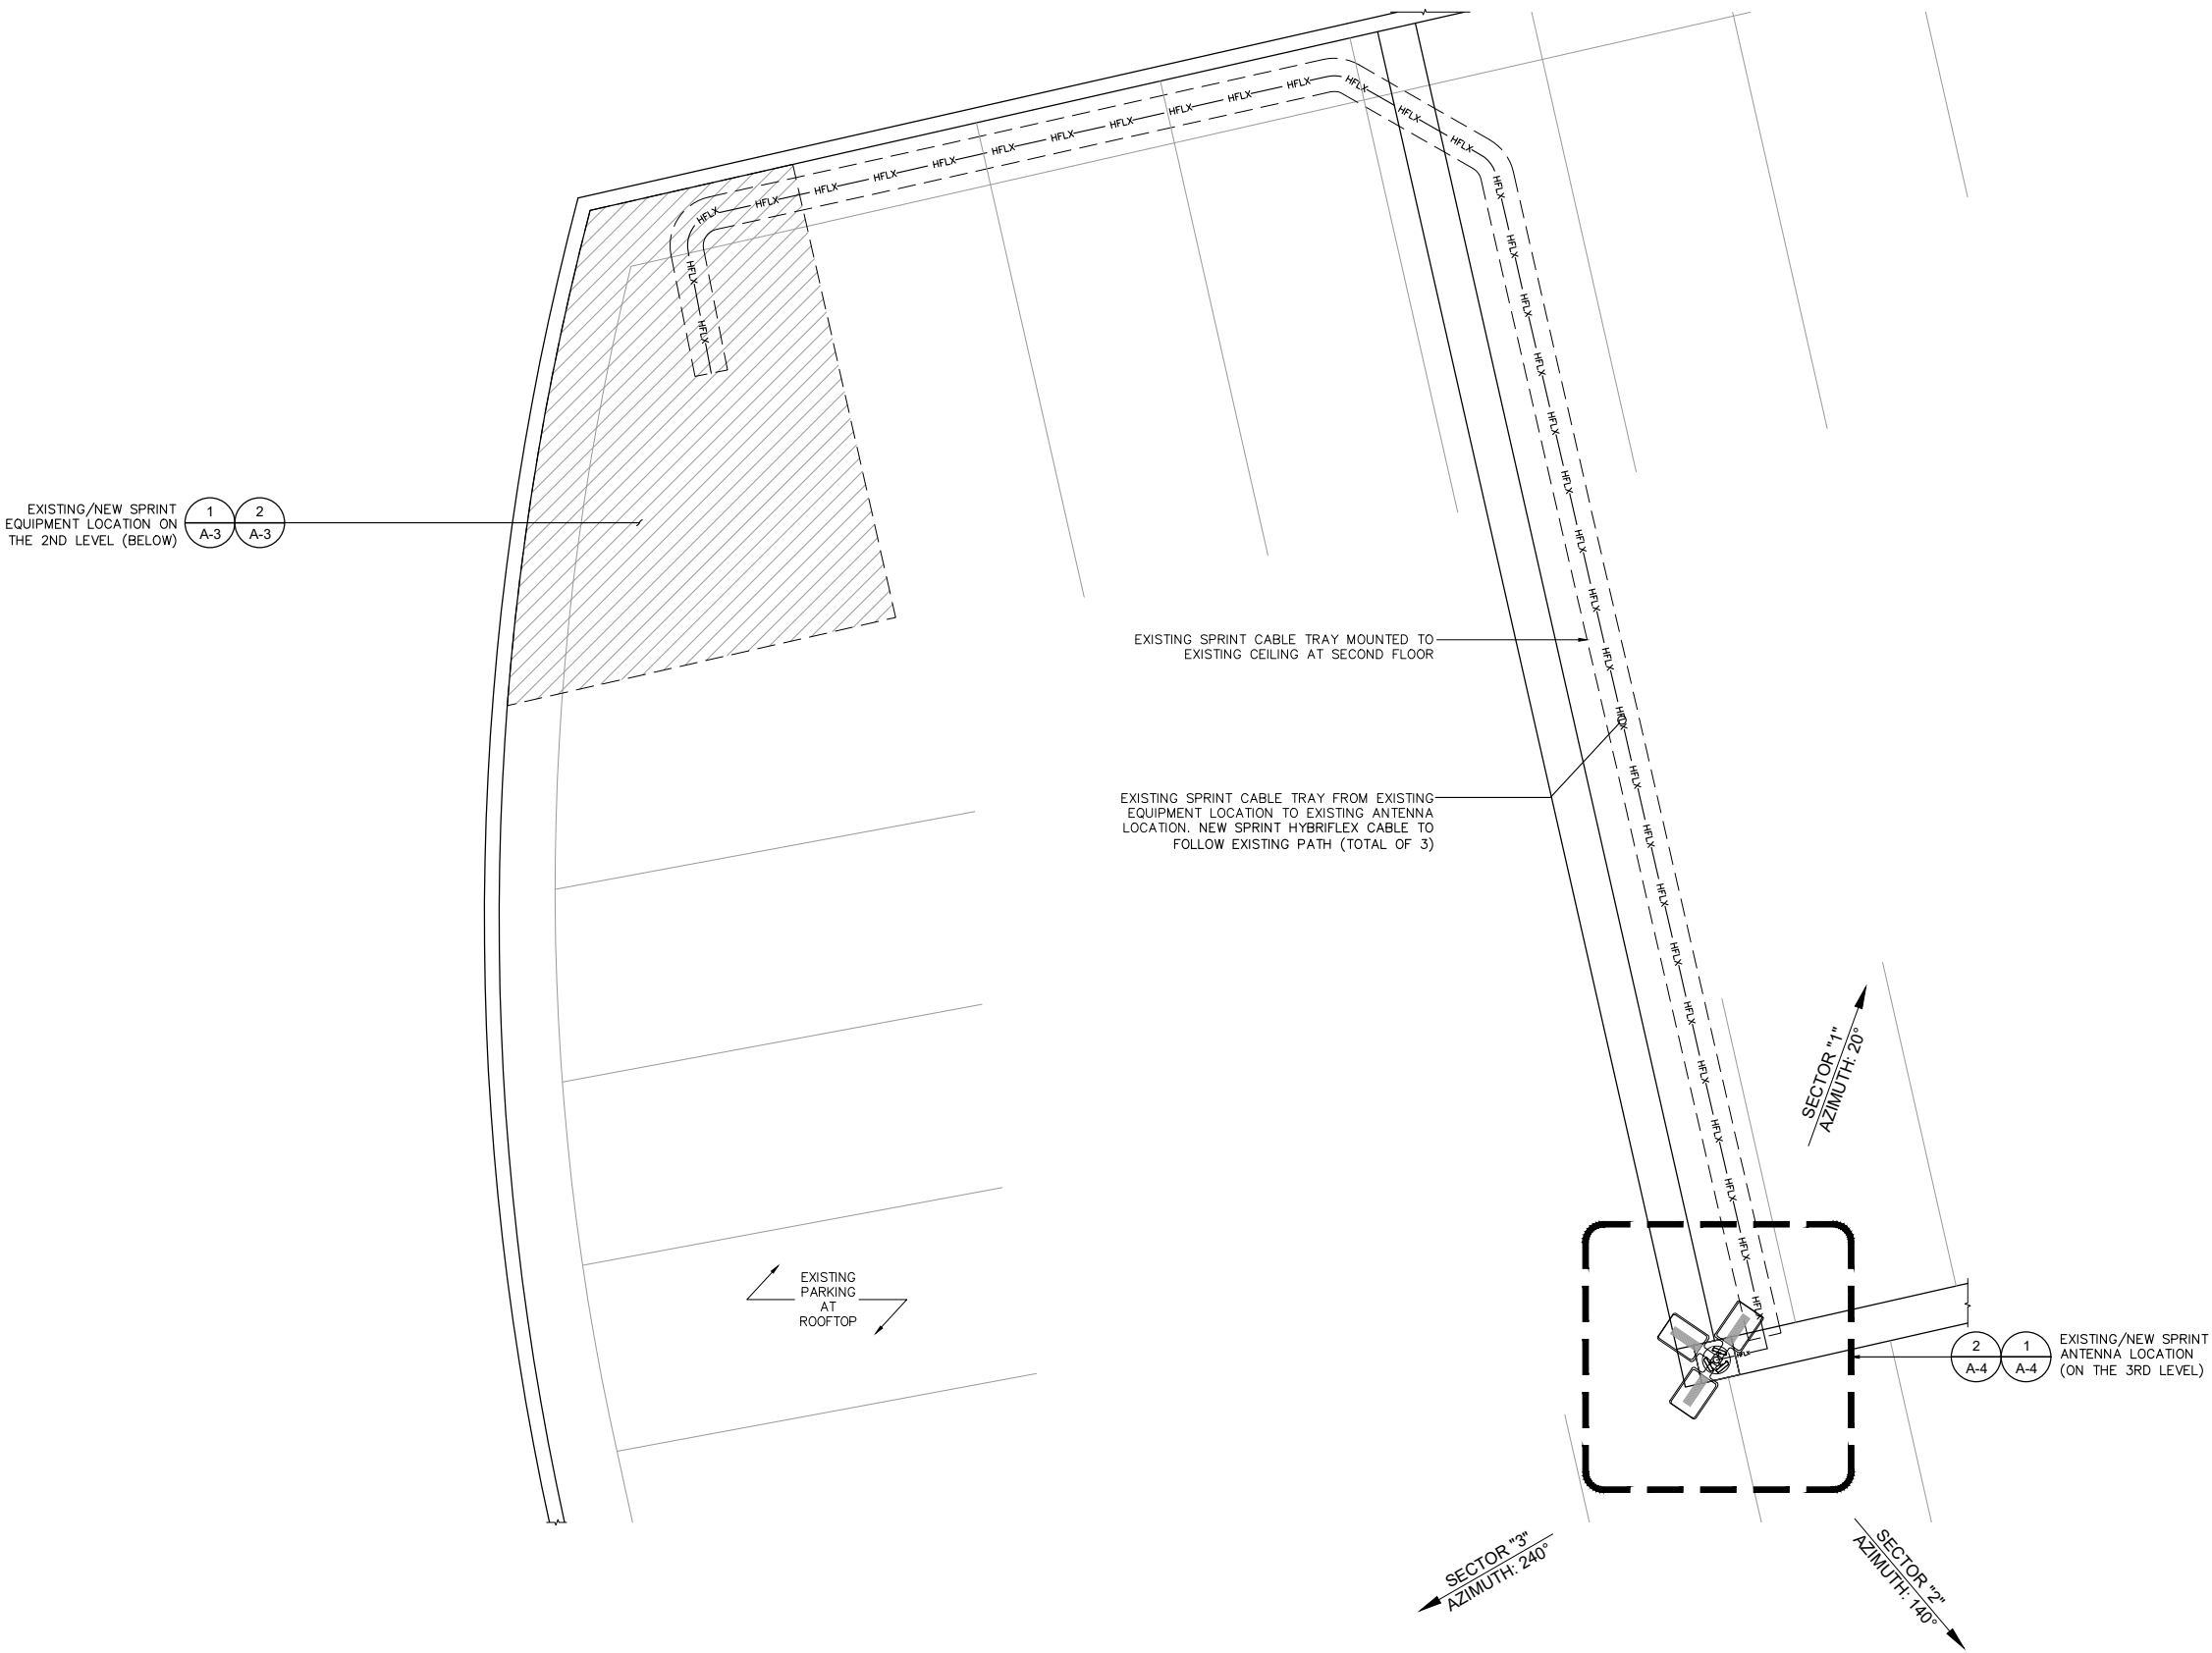

APPLICANT:

Sprint

6591 IRVINE CENTER DRIVE SUITE 100
IRVINE, CA 92618

ENGINEER:

Eukon
an SFC Communications, Inc. Company

65 POST, SUITE 1000
IRVINE, CA 92618
TEL: (949) 553-8566
www.eukongroup.com

DRAWN BY: TC/EL/CB/JAR
CHECKED BY: JAR

REVISIONS:

REV	DATE	DESCRIPTION
3	01/10/19	DRM COMMENTS
2	08/19/19	PER SITE WALK
1	07/09/19	REDESIGN
0	12/13/17	100% CONSTRUCTION DRAWING
A	10/30/17	90% CONSTRUCTION DRAWING

LICENSER:

EXP. DATE: 12-31-21

DATE SIGNED: 10-23-18

PROJECT INFORMATION:

PACIFICO

LA57XC302

1301 HERMOSA AVE
HERMOSA BEACH, CA 90255


SHEET TITLE:

EXISTING ENLARGED
SITE PLAN

SHEET NUMBER:

A-2

SCALE NOTE:
IF DIMENSIONS SHOWN ON PLAN DO NOT SCALE CORRECTLY, CHECK FOR REDUCTION OR ENLARGEMENT FROM ORIGINAL PLANS.

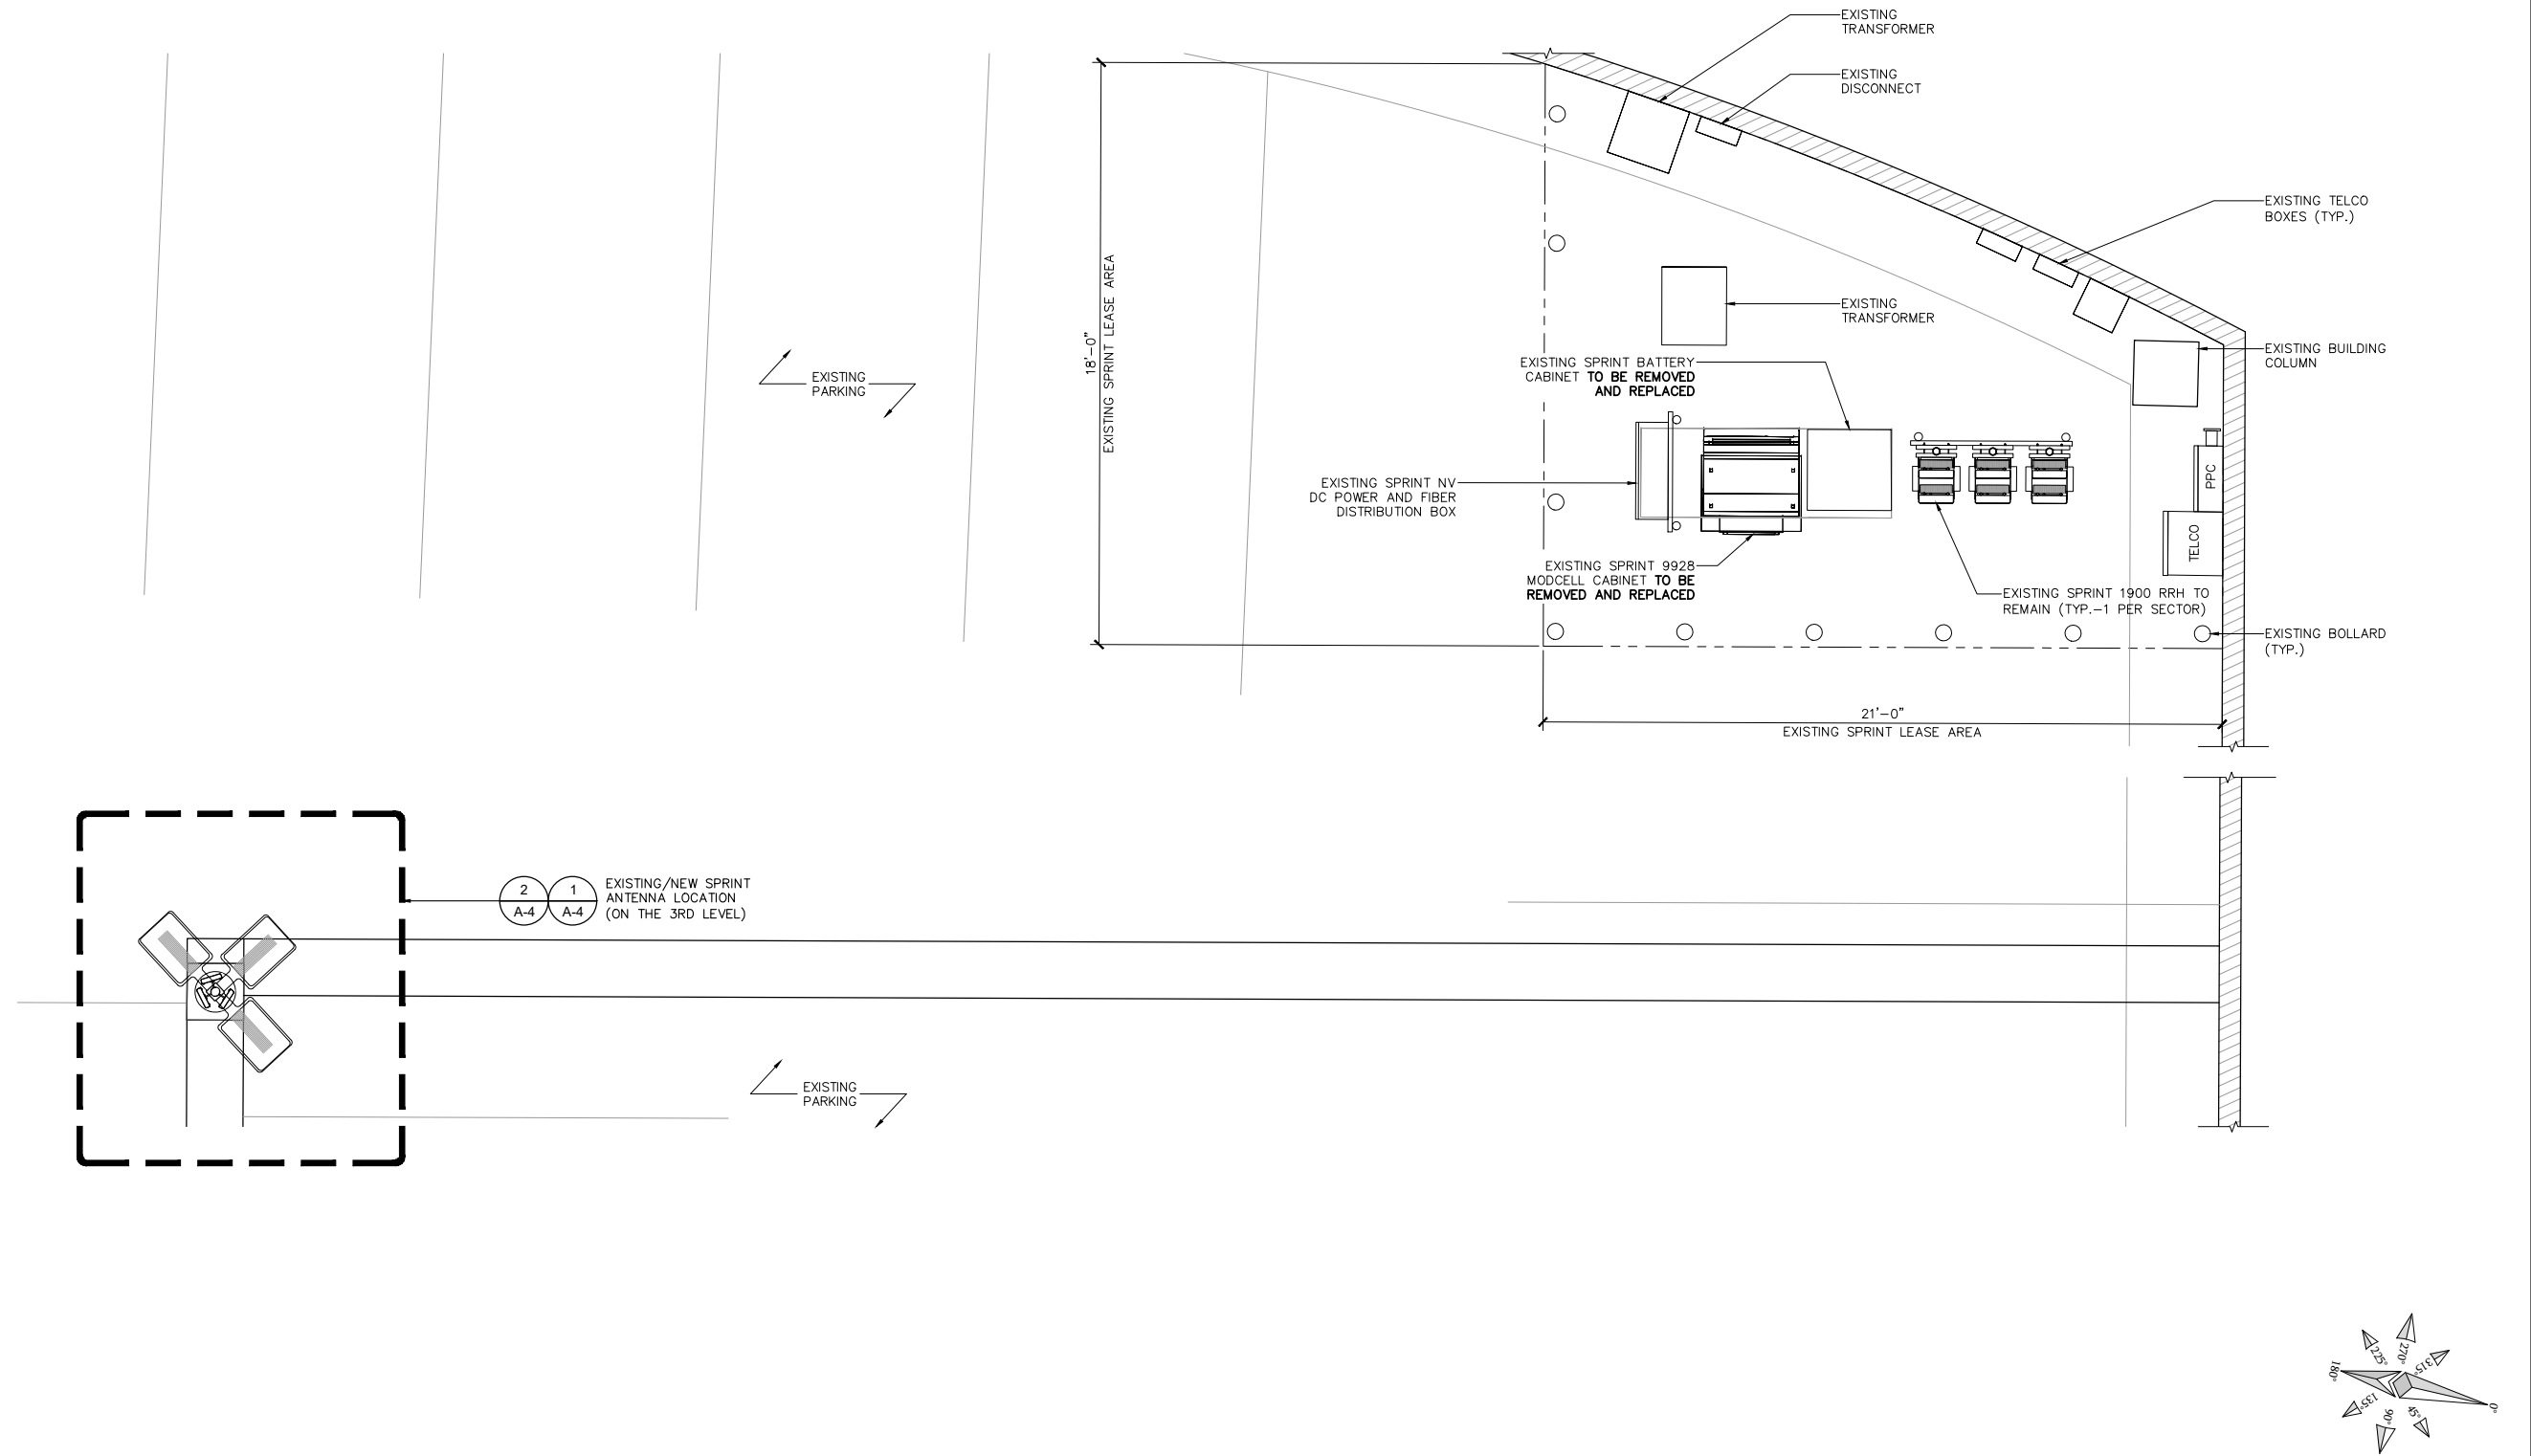

APPLICANT:

Sprint

6591 IRVINE CENTER DRIVE SUITE 100
IRVINE, CA 92618

ENGINEER:

Eukon
an SFC Communications, Inc. Company

65 POST, SUITE 1000
IRVINE, CA 92618
TEL: (949) 553-8566
www.eukongroup.com

DRAWN BY: TC/EL/CB/JAR
CHECKED BY: JAR

REVISIONS:		
REV	DATE	DESCRIPTION
3	01/10/19	DRM COMMENTS
2	08/19/19	PER SITE WALK
1	07/09/19	REDESIGN
0	12/13/17	100% CONSTRUCTION DRAWING
A	10/30/17	90% CONSTRUCTION DRAWING

LICENSER:

EXP. DATE: 12-31-21

DATE SIGNED: 10-23-18

PROJECT INFORMATION:

PACIFICO

LA57XC302

1301 HERMOSA AVE
HERMOSA BEACH, CA 90255

SHEET TITLE:

EXISTING EQUIPMENT LAYOUT



SHEET NUMBER:

A-3

SCALE NOTE:
IF DIMENSIONS SHOWN ON PLAN DO
NOT SCALE CORRECTLY, CHECK FOR
REDUCTION OR ENLARGEMENT FROM
ORIGINAL PLANS.


NOTE:
G.C. TO INSTALL NEW SIGNAGE

NOTE:
G.C. TO X-RAY PARKING STRUCTURE.
NOTIFY ENGINEER IF FIELD
CONDITIONS VARY

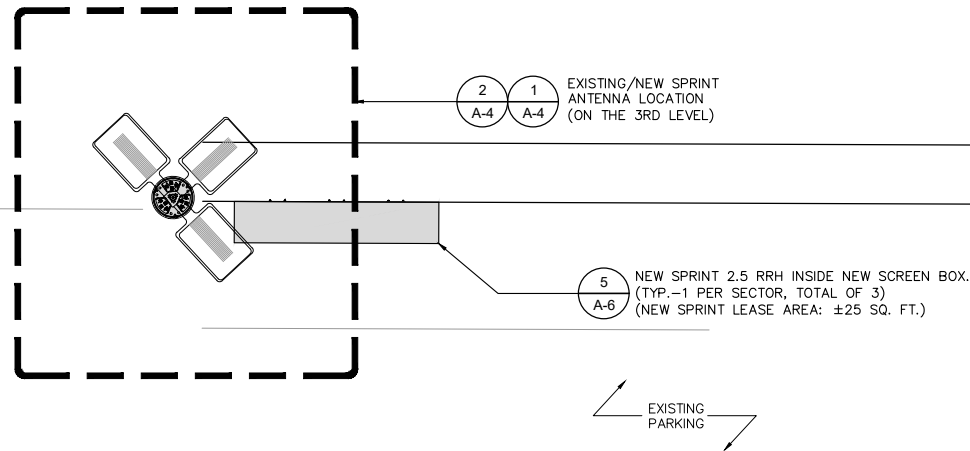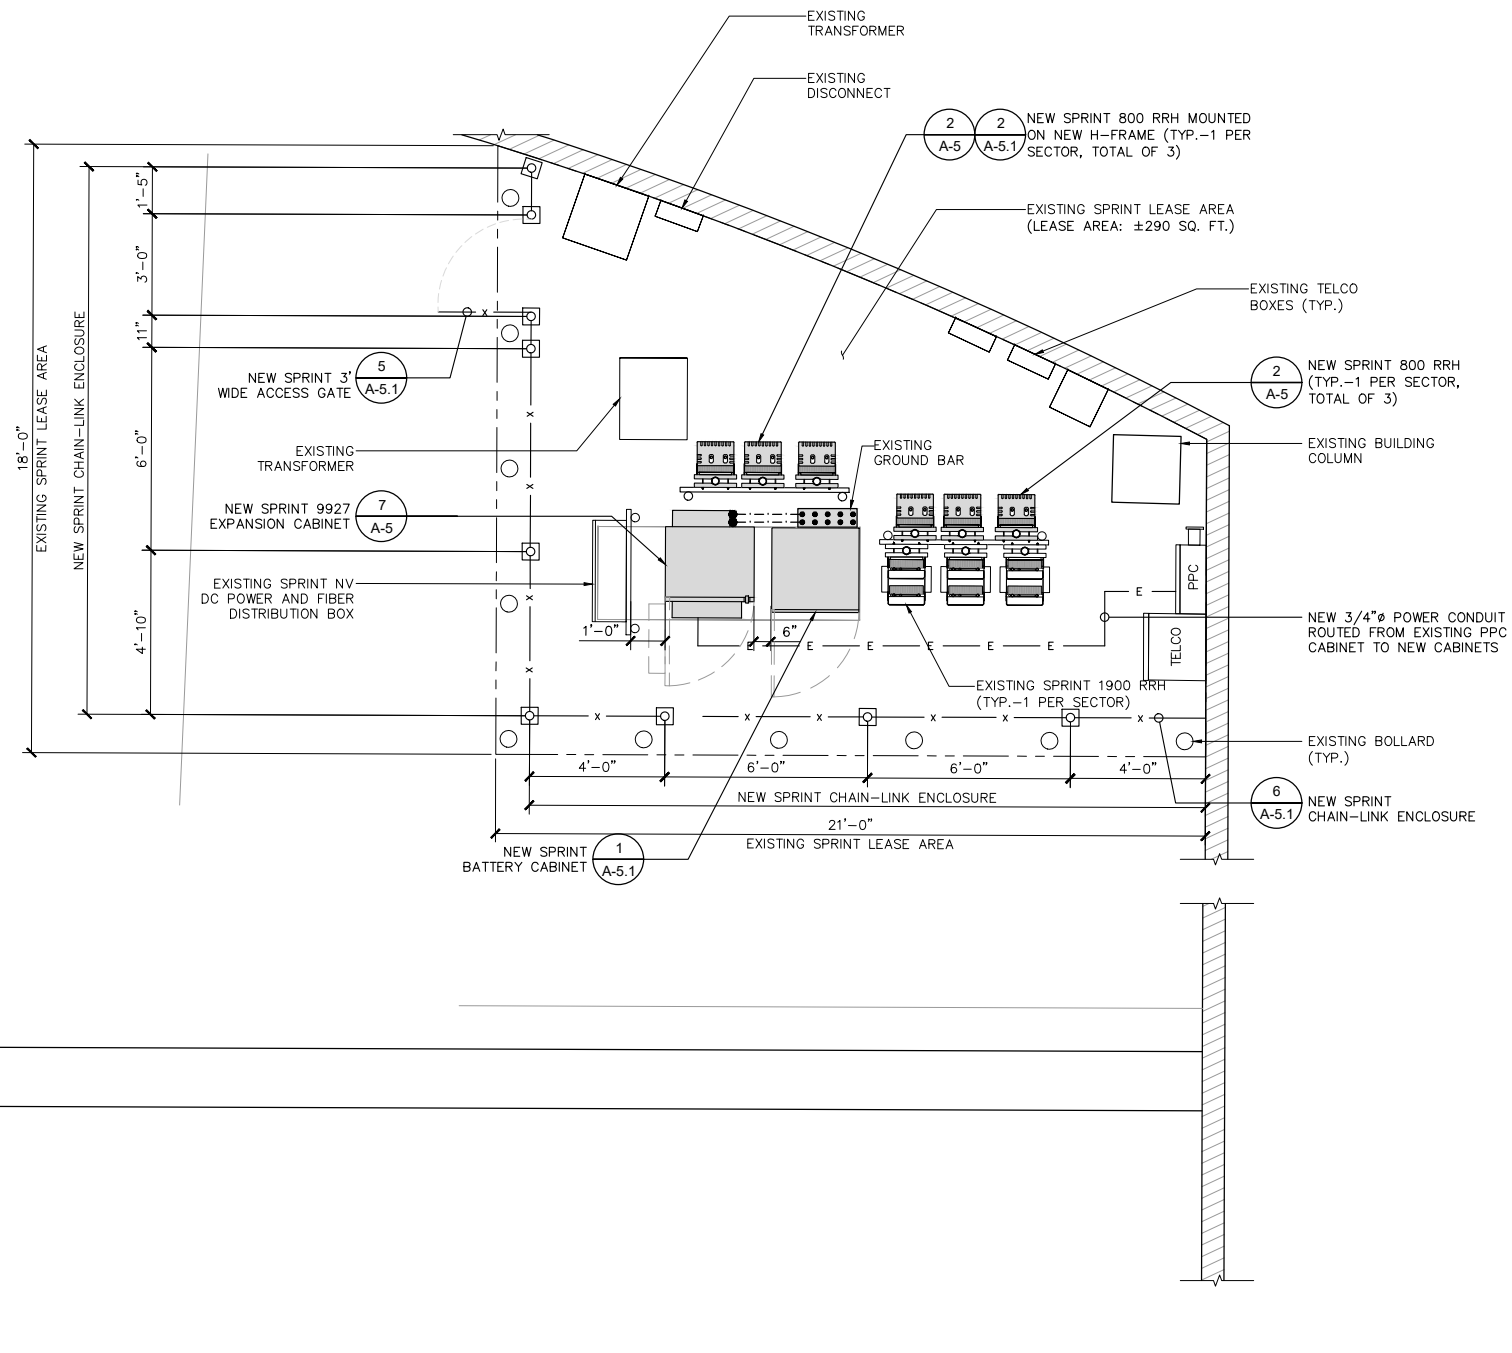

NEW EQUIPMENT LAYOUT

SCALE
3/8"=1'-0"

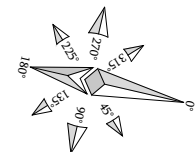

APPLICANT:

Sprint

6591 IRVINE CENTER DRIVE SUITE 100
IRVINE, CA 92618

ENGINEER:

Eukon
an SFC Communications, Inc. Company

65 POST, SUITE 1000
IRVINE, CA 92618
TEL: (949) 553-8566
www.eukongroup.com

DRAWN BY: TC/EL/CB/JAR
CHECKED BY: JAR

REVISIONS:

REV	DATE	DESCRIPTION
3	01/10/19	DRM COMMENTS
2	08/19/19	PER SITE WALK
1	07/09/19	REDESIGN
0	12/13/17	100% CONSTRUCTION DRAWING
A	10/30/17	90% CONSTRUCTION DRAWING

LICENSER:



EXP. DATE: 12-31-21

DATE SIGNED: 10-23-18

PROJECT INFORMATION:

PACIFICO

LA57XC302

1301 HERMOSA AVE
HERMOSA BEACH, CA 90255


SHEET TITLE:

**NEW EQUIPMENT
LAYOUT**

SHEET NUMBER:


A-3.1

SCALE NOTE:
IF DIMENSIONS SHOWN ON PLAN DO NOT SCALE CORRECTLY, CHECK FOR REDUCTION OR ENLARGEMENT FROM ORIGINAL PLANS.

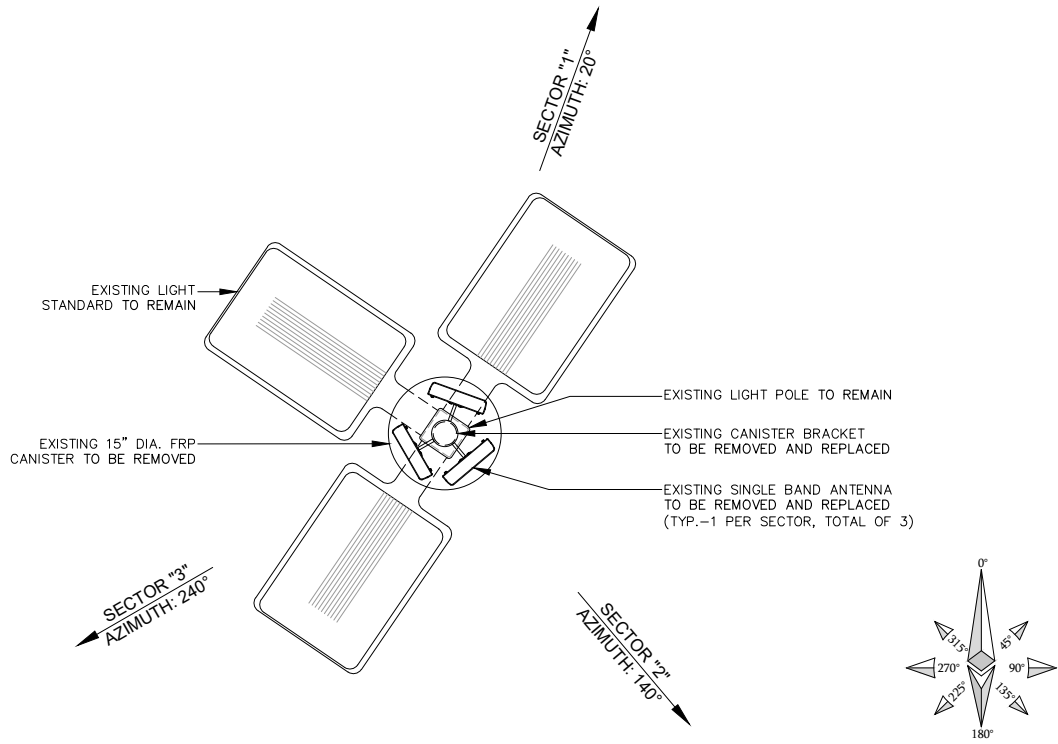

EXISTING ANTENNA PLAN

SCALE
1" = 1'-0"

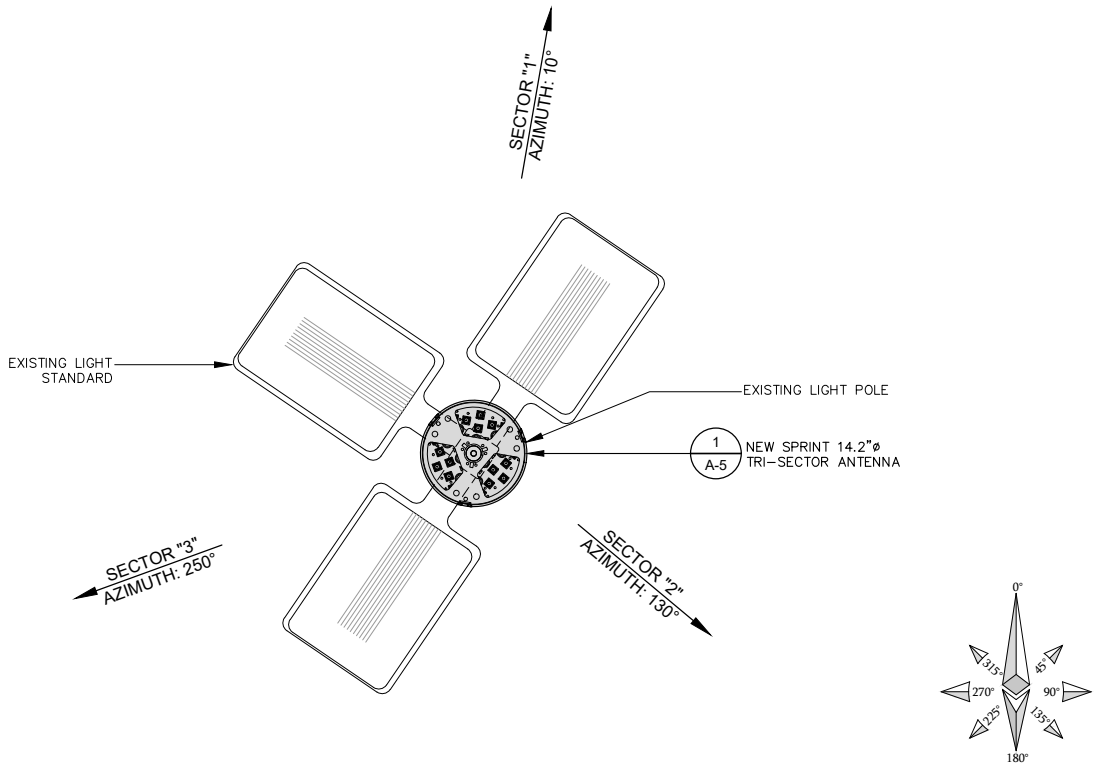

NEW ANTENNA PLAN

SCALE
1" = 1'-0"

NOTES TO CONTRACTOR

- CONTRACTOR IS TO REFER TO SPRINT'S MOST CURRENT RF DESIGN PRIOR TO CONSTRUCTION.
- CABLE LENGTHS WERE DETERMINED BASED ON A VISUAL INSPECTION DURING SITE WALK. CONTRACTOR TO VERIFY ACTUAL LENGTH DURING PRE-CONSTRUCTION WALK.
- CONTRACTOR TO USE MANUFACTURER'S FIBER LINE HANGER COMPONENTS (OR ENGINEER APPROVED EQUAL).
- CONTRACTOR TO USE CABLES SPECIFIED (OR ENGINEER APPROVED EQUAL).

ANTENNA AND RRH SCHEDULE																						
SECTOR	POSITION	TECHNOLOGY		ANTENNA TYPE		ANTENNA SIZE		AZIMUTH	RAD CENTER		EXISTING TRANSMISSION CABLE				NEW TRANSMISSION CABLE				RRH MODEL		COMBINERS	
		EXISTING	FINAL	EXISTING	FINAL	EXISTING	FINAL		EXISTING	FINAL	LENGTH	QTY.	TYPE	DIA. Ø	LENGTH	QTY.	TYPE	DIA. Ø	EXISTING	FINAL	TYPE	QTY.
1	1	1900	2.5/800/1900	APXVSP18-C	ALPHA AW3631	-	78"L x 14.2"Ø	20°	±43'-6"	±43'-6"	170'	3	COAX	V.I.F.	170'	6	COAX	7/8"Ø	1900 RRH	(2) 800 RHH 2.5 RRH 1900 RRH	-	-
	2	-	-	-	-	-	-	-	-	-	-	-	-	-	-	-	-	-	-	-	-	
	3	-	-	-	-	-	-	-	-	-	-	-	-	-	-	-	-	-	-	-	-	
2	1	1900	2.5/800/1900	APXVSP18-C	ALPHA AW3631	-	78"L x 14.2"Ø	140°	±43'-6"	±43'-6"	170'	3	COAX	V.I.F.	170'	6	COAX	7/8"Ø	1900 RRH	(2) 800 RHH 2.5 RRH 1900 RRH	-	-
	2	-	-	-	-	-	-	-	-	-	-	-	-	-	-	-	-	-	-	-	-	
	3	-	-	-	-	-	-	-	-	-	-	-	-	-	-	-	-	-	-	-	-	
3	1	1900	2.5/800/1900	APXVSP18-C	ALPHA AW3631	-	78"L x 14.2"Ø	240°	±43'-6"	±43'-6"	170'	1	COAX	V.I.F.	170'	6	COAX	7/8"Ø	1900 RRH	(2) 800 RHH 2.5 RRH 1900 RRH	-	-
	2	-	-	-	-	-	-	-	-	-	-	-	-	-	-	-	-	-	-	-	-	
	3	-	-	-	-	-	-	-	-	-	-	-	-	-	-	-	-	-	-	-	-	

* V.I.F. = VERIFY IN FIELD

ANTENNA AND RRH SCHEDULE

SCALE
NONE

3

APPLICANT:



6591 IRVINE CENTER DRIVE SUITE 100
IRVINE, CA 92618

ENGINEER:



65 POST, SUITE 1000
IRVINE, CA 92618
TEL: (949) 553-8566
www.eukongroup.com

DRAWN BY: TC/EL/CB/JAR
CHECKED BY: JAR

REVISIONS:

REV	DATE	DESCRIPTION
3	01/10/19	DRM COMMENTS
2	08/19/19	PER SITE WALK
1	07/09/19	REDESIGN
0	12/13/17	100% CONSTRUCTION DRAWING
A	10/30/17	90% CONSTRUCTION DRAWING

LICENSER:



EXP. DATE: 12-31-21

DATE SIGNED: 10-23-18

PROJECT INFORMATION:

PACIFICO

LA57XC302

1301 HERMOSA AVE
HERMOSA BEACH, CA 90255


SHEET TITLE:

EXISTING /NEW ANTENNA
PLANS & ANTENNA / RRH
SCHEDULE

SHEET NUMBER:

A-4

SCALE NOTE:
IF DIMENSIONS SHOWN ON PLAN DO
NOT SCALE CORRECTLY, CHECK FOR
REDUCTION OR ENLARGEMENT FROM
ORIGINAL PLANS.

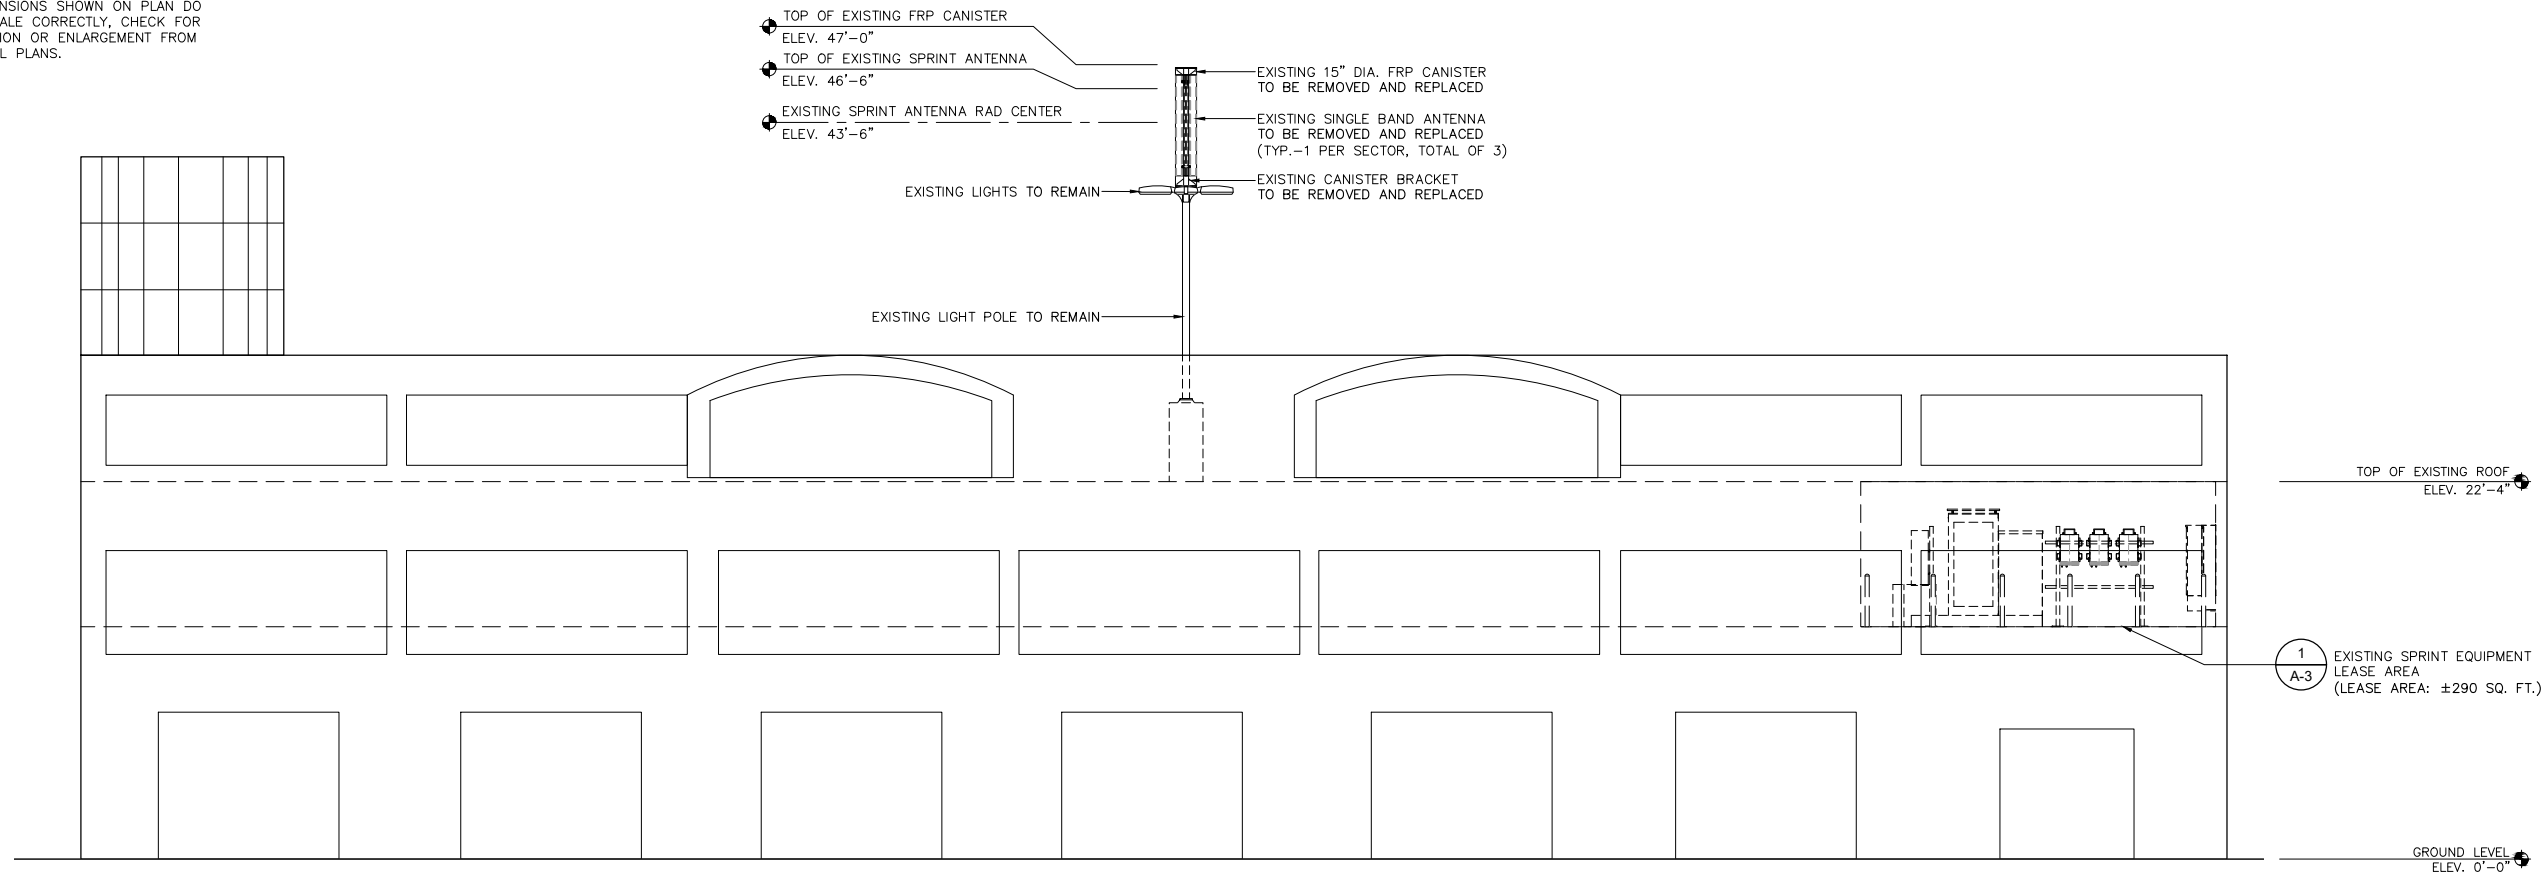


EXISTING WEST ELEVATION

SCALE
3/16"=1'-0"



1

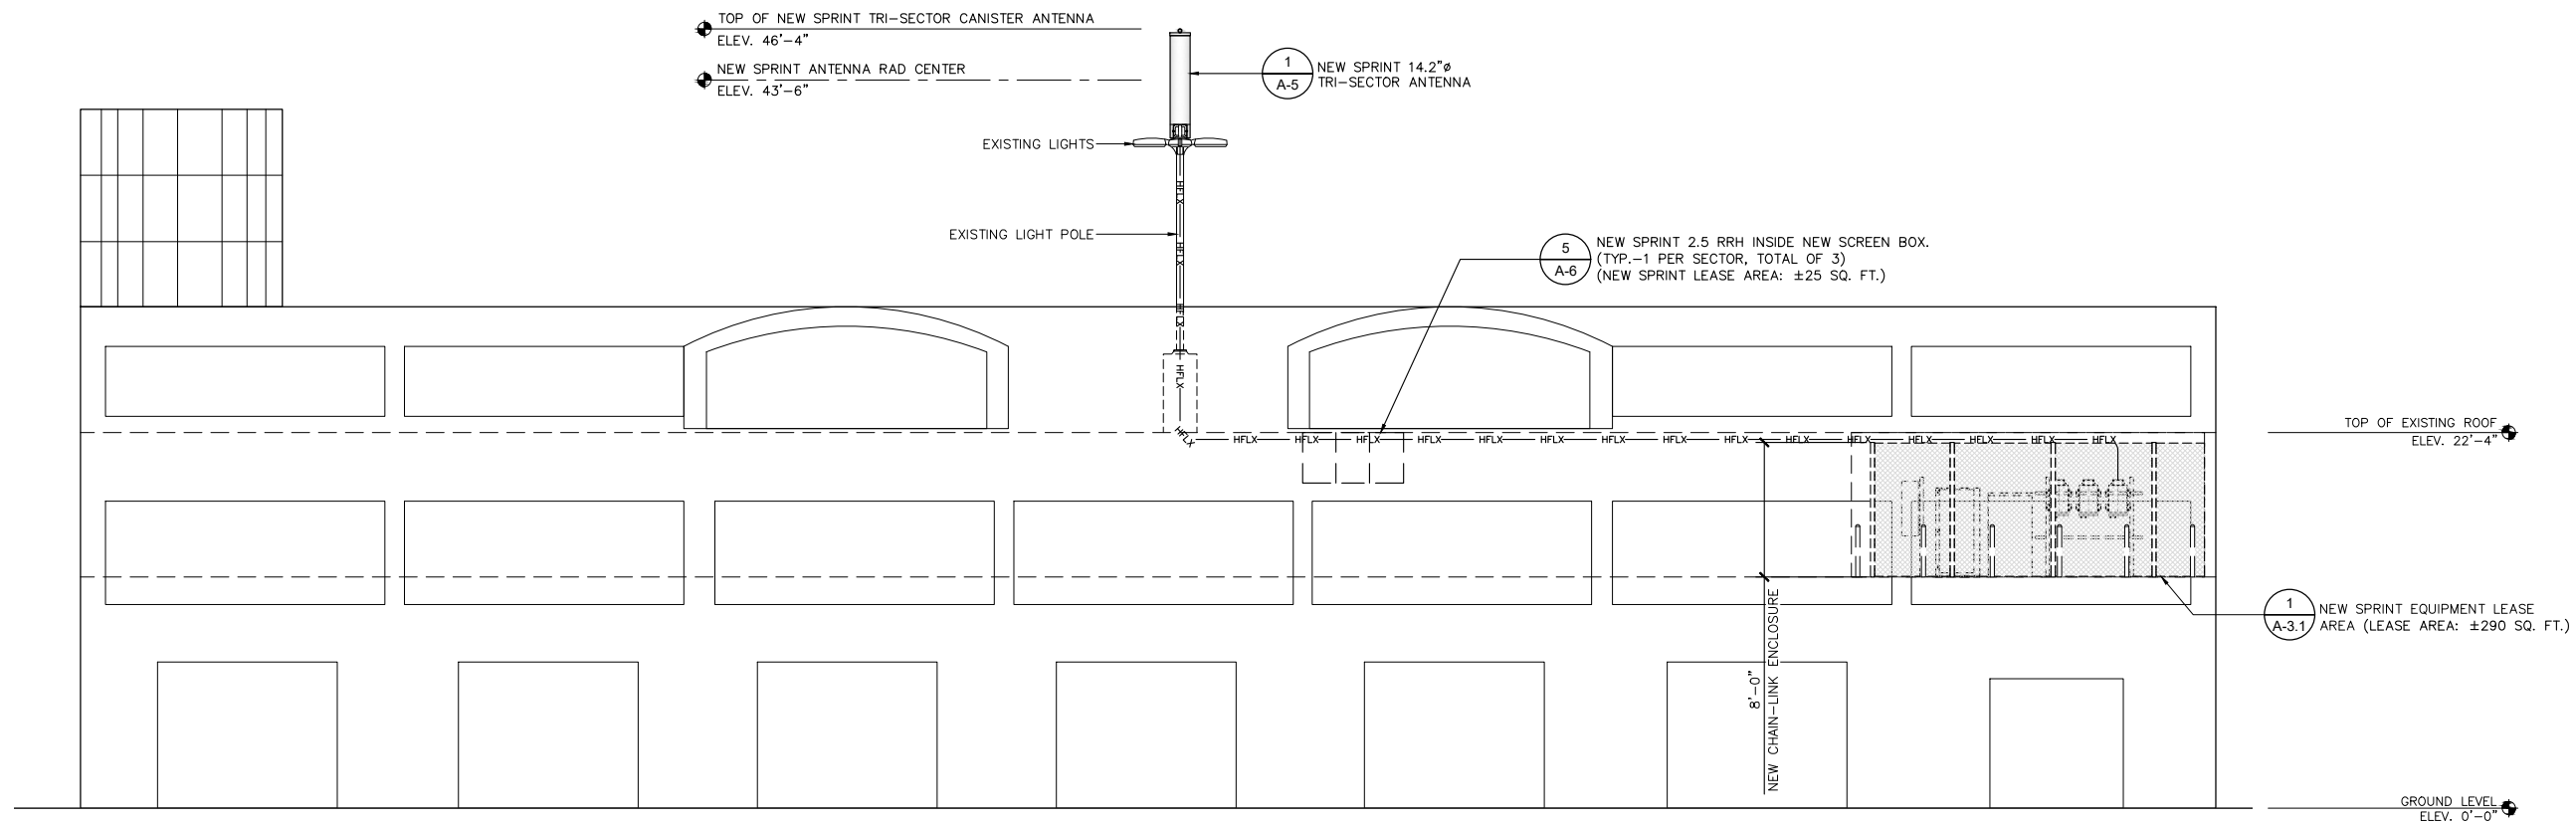

NEW WEST ELEVATION

SCALE
3/16"=1'-0"



2

APPLICANT:

Sprint

6591 IRVINE CENTER DRIVE SUITE 100
IRVINE, CA 92618

ENGINEER:

Eukon
an SFC Communications, Inc. Company

65 POST, SUITE 1000
IRVINE, CA 92618
TEL: (949) 553-8566
www.eukongroup.com

DRAWN BY: TC/EL/CB/JAR
CHECKED BY: JAR

REVISIONS:

REV	DATE	DESCRIPTION
3	01/10/19	DRM COMMENTS
2	08/19/19	PER SITE WALK
1	07/09/19	REDESIGN
0	12/13/17	100% CONSTRUCTION DRAWING
A	10/30/17	90% CONSTRUCTION DRAWING

LICENSER:



EXP. DATE: 12-31-21

DATE SIGNED: 10-23-18

PROJECT INFORMATION:

PACIFICO

LA57XC302

1301 HERMOSA AVE
HERMOSA BEACH, CA 90255

SHEET TITLE:

EXISTING AND NEW
WEST ELEVATIONS

SHEET NUMBER:

A-4.1

HOOK THE RRUS ONTO THE STUD BOLTS ON THE WALL BRACKETS. MOUNT THE WASHERS AND THE NUTS ONTO THE STUD BOLTS ON THE UPPER BRACKET AND INSERT THE BOLTS WITH WASHERS IN THE LOWER FIXTURE.

TIGHTEN THE M10 NUTS AND BOLTS TO A TORQUE OF 41 Nm, USING A TORQUE WRENCH FITTED WITH A 16MM SOCKET.

AT&T MOBILITY CONTRACTOR TO INSTALL (2) 1 5/8" x 1 5/8" UNISTRUT CHANNELS TO NEW H-FRAME WITH 1/2" COATED STEEL BOLTS, 2H HEAVY HEX NUTS & F436 STRUCTURAL WASHERS

NOTE: RRUS TO BE MOUNTED TO UNISTRUT CHANNEL WITH 1/2" COATED STEEL, BOLTS, 2H HEAVY HEX NUTS & F436 STRUCTURAL WASHERS

MAIN SUPPORT BRACKET (ALCATEL-LUCENT #849147038)

NEW RRH

NEW 3" DIA SHARED ANTENNA MAST MOUNT

MAST MOUNT BRACKET (ALCATEL-LUCENT #849073713), (2) PER RRH

SIDE SUPPORT BRACKET WITH EARS (ALCATEL-LUCENT #849147053), (2) PER RRH WHEN REQUIRED

ANTENNA MOUNTING NOTES

- APPROXIMATE LENGTH OF (1) FIBER CABLE RUN = APPROX. LENGTH OF ICE BRIDGE + ANTENNA MOUNTING HEIGHT + 20 FEET
- CONTRACTOR SHALL VERIFY THE DOWNTILT OF EACH ANTENNA WITH A DIGITAL LEVEL.
- CONTRACTOR TO CONFIRM FIBER CABLE COLOR CODING PRIOR TO CONSTRUCTION.

CABLE MARKING NOTES

- ALL CABLES SHALL BE MARKED WITH 2" WDE, UV STABILIZED, UL APPROVED TAPE.
- THE FIRST RING SHALL BE CLOSEST TO THE END OF THE CABLE AND SPACED APPROXIMATELY 2" FROM THE END CONNECTOR, WEATHERPROOFING, OR BREAKOUT UNIT. THERE SHALL BE 1" SPACE BETWEEN EACH RING.
- A 2" GAP SHALL SEPARATE THE CABLE COLOR CODE FROM THE FREQUENCY COLOR CODE. THE 2" COLOR RINGS FOR THE FREQUENCY CODE SHALL BE PLACED NEXT TO EACH OTHER WITH NO SPACES.
- THE 2" COLORED TAPE(S) SHALL BE WRAPPED A MINIMUM OF 3 TIMES AROUND THE INDIVIDUAL CABLES, AND THE TAPE SHALL BE KEPT IN THE SAME LOCATION AS MUCH AS POSSIBLE.
- SITES WITH MORE THAN FOUR (4) SECTORS WILL REQUIRE ADDITIONAL RINGS FOR EACH SECTOR, FOLLOWING THE PATTERN. HIGH CAPACITY SITES WILL USE THE SECOND CABLE IDENTIFIED BY BLUE BANDS OF TAPE.
- FIBER FIBER CABLE SHALL BE SECTOR IDENTIFIED INSIDE THE CABINET ON FREQUENCY BUNDLES, ON THE SEALTITE, ON THE MAIN LINE UPON EXIT OF SEALTITE, AND BEFORE AND AFTER THE BREAKOUT UNIT (MEDUSA), AS WELL AS BEFORE AND AFTER ANY ENTRANCE OR EXIT.
- HFC "MAIN TRUNK" WILL NOT BE MARKED WITH THE FREQUENCY CODES, AS IT CONTAINS ALL FREQUENCIES.
- INDIVIDUAL POWER PAIRS AND FIBER BUNDLES SHALL BE LABELED WITH BOTH THE CABLE AND FREQUENCY.

RRU ATTACHMENT DETAIL

8

RRU ATTACHMENT DETAIL

6

NOT USED

5

ANTENNA MOUNTING NOTES

3

ALU 9927 RAN - CABINET

DISTRIBUTED BASE STATION

OUTDOOR CABINET

CABINET DIMENSIONS

HEIGHT: 63.5" (1613 mm)

WIDTH: 31.5" (800 mm)

DEPTH: 38.1" (967 mm)

WEIGHT: 594 lbs

FRONT

PLAN VIEW

FRONT ELEVATION

SIDE ELEVATION

NOTES:

- SEE EQUIPMENT CUT SHEETS FOR BOLT HOLE SPACING.
- PROVIDE (4) 1/2" HILTI KWIK BOLT TZ SS ANCHOR PER EQUIPMENT CABINET PER DETAIL 3/A-5.1.

ALCATEL-LUCENT TD-RRH8x20

REMOTE RADIO HEAD

PHYSICAL DIMENSIONS

- HEIGHT: 26.02" (661 mm)
- WIDTH: 18.54" (471 mm)
- DEPTH: 6.65" (169 mm)
- WEIGHT: 72.75lbs (33Kg) (WITHOUT SOLAR SHIELD & MOUNTING BRACKETS)

POWER:

- POWER SUPPLY: -48 VDC

DIGITAL PORTS AND ALARMS

- THREE OPTICAL PORTS
- TWO EXTERNAL ALARMS

OPERATING ENVIRONMENT

- OUTDOOR TEMPERATURE RANGE FROM -40°C UP TO +55°C
- PASSIVE CONVECTION COOLING (NO FANS)
- IP65 ENCLOSURE PROTECTION (INTERNATIONAL PROTECTION RATING)

RF CHARACTERISTICS

- FREQUENCY BANDS SUPPORTED: -2496MHz TO 2690MHz (3GPP BAND 41)
- INSTANTANEOUS BANDWIDTH OF 60 MHz
- RF OUTPUT POWER AT ANTENNA PORT UP TO 20W NOMINAL
- RX DIVERSITY 8-WAY
- NOISE FIGURE: 3.2 dB TYPICAL
- ANTENNA LINE DEVICE FEATURES REMOTE ELECTRICAL TILT (RET) SUPPORT VIA AISG V2.0

OPTICAL CHARACTERISTICS

- SINGLE-MODE DUAL FIBER (SMDF) VARIANT UP TO 10 km OR MULTI-MODE DUAL FIBER (MMDF)

RRH MOUNTING REFER TO:

MANUFACTURER: ALU
MODEL: 800 MHz, 2x50W
WEIGHT: 53 LBS
POWER SUPPLY: -48 VDC

TOP

SIDE

FRONT

NEW SPRINT 2.5 RRH.

EXISTING OR NEW 3" MOUNTING PIPE

RRH MOUNTING PER MANUFACTURERS SPECIFICATIONS

ATTACH RRH PER MANUFACTURERS SPECIFICATIONS

ALARM

AISG

CPRI CALIBRATION ANTENNA

POWER ANTENNA

SIDE VIEW

FRONT VIEW

MOUNTING DETAIL

PLAN VIEW

RRH 800 SPECIFICATIONS

ALPHA-AW3631

TRI-SECTOR ANTENNA

MECHANICAL SPECIFICATIONS

- HEIGHT: 78" (1980 mm)
- DIAMETER: 14.2" (360 mm)
- WEIGHT (ANTENNA): 50 lbs (110 Kg)
- WEIGHT (MOUNT): 27.1 lbs (12.3 Kg)
- CONNECTOR TYPE (FEMALE): 4.3-10, (6P Low Band, 12P High Band)
- CONNECTOR POSITION: BOTTOM
- CONNECTOR QUANTITY: 18
- WINDLOAD FRONTAL/LATERAL (AT RATED WIND SPEED: 150km/h): 550 N (124 lbf)
- SURVIVAL WIND SPEED: 200 km/h (125 mph)
- RADOME MATERIAL: UV-STABILISED PVC
- RADOME COLOUR: 9010 RAL
- PRODUCT COMPLIANCE ENVIRONMENTAL: RoHS
- LIGHTENING PROTECTION: DC GROUNDED
- COLD TEMPERATURE SURVIVAL: -40°C (-40°F)
- HOT TEMPERATURE SURVIVAL: 70°C (158°F)

FRONT

BOTTOM

ALU 9927 EQUIPMENT SPECIFICATIONS

7

2500 RRH (TD-RRH8x20)

4

TRI-SECTOR ANTENNA SPECIFICATIONS

1

APPLICANT:

Sprint

6591 IRVINE CENTER DRIVE SUITE 100
IRVINE, CA 92618

ENGINEER:

Eukon
an SFC Communications, Inc. Company

65 POST, SUITE 1000
IRVINE, CA 92618
TEL: (949) 553-8566
www.eukongroup.com

DRAWN BY:

TC/EL/CB/JAR

CHECKED BY:

JAR

REVISIONS:

REV	DATE	DESCRIPTION
3	01/10/19	DRM COMMENTS
2	08/19/19	PER SITE WALK
1	07/09/19	REDESIGN
0	12/13/17	100% CONSTRUCTION DRAWING
A	10/30/17	90% CONSTRUCTION DRAWING

LICENSER:

EXP. DATE: 12-31-21

DATE SIGNED: 10-23-18

PROJECT INFORMATION:

PACIFICO

LA57XC302

1301 HERMOSA AVE
HERMOSA BEACH, CA 90255

SHEET TITLE:

EQUIPMENT DETAILS




SHEET NUMBER:

A-5

ALU 60ECv2 - BBC
BATTERY BACKUP CABINET

CABINET DIMENSIONS
HEIGHT: 60" (1524 mm)
WIDTH: 31" (787.4 mm)
DEPTH: 30" (762 mm)
WEIGHT: 2830lbs
(CABINET, BATTERIES, CSR, 18BU)




- NOTES:
- SEE EQUIPMENT CUT SHEETS FOR BOLT HOLE SPACING.
 - PROVIDE (4) 1/2" HILTI KWIK BOLT TZ SS ANCHOR PER EQUIPMENT CABINET PER DETAIL 3/A-5.1.

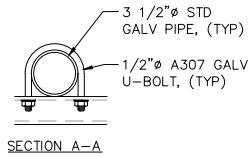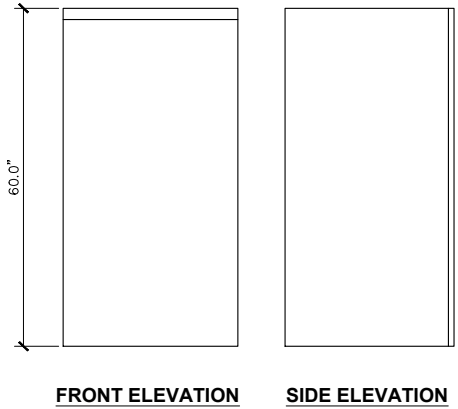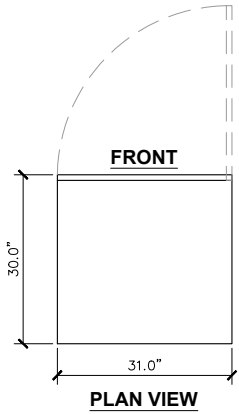

WB-BS
BASE SHOE FOR 3-1/2" OD PIPE, HARDWARE INCLUDED

WIDTH	203.2MM	8.0 IN
HEIGHT	152.4MM	6.0 IN
LENGTH	203.2MM	8.0 IN
WEIGHT	8.7KG	19.2 LB


GENERAL SPECIFICATIONS	
PRODUCT TYPE	BASE SHOES
APPLICATION	BASE SHOE
INCLUDES	HARDWARE MOUNT
MATERIAL TYPE	HOT DIP GALVANIZED STEEL
MOUNTING	PIPE, 88.9 MM (3-1/2") OD
PACKAGE QUANTITY	1

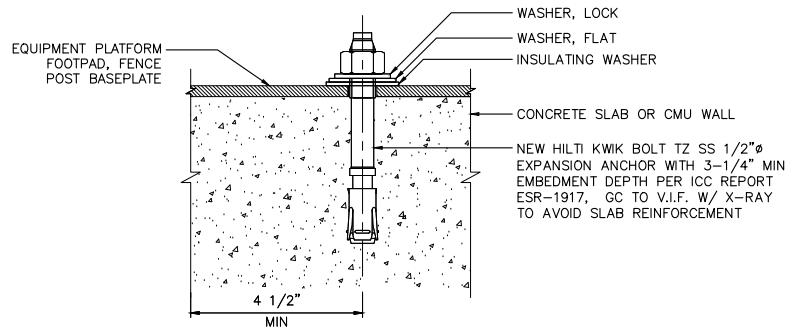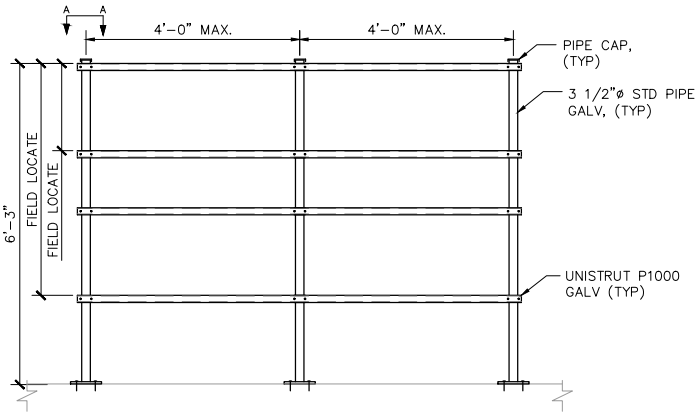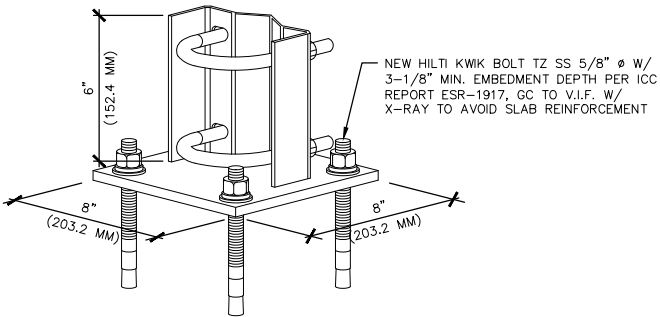

CONCRETE ANCHORAGE

3

NOTE:
CONCRETE NOT SHOWN FOR CLARITY

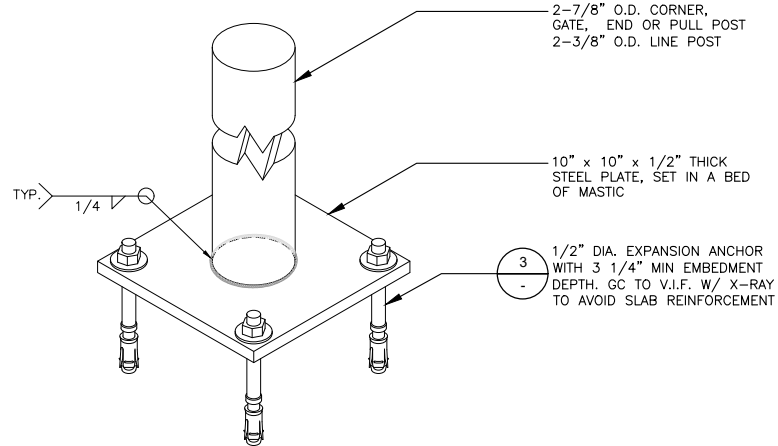

NEW 60ECv2 - BBC



1

NEW H-FRAME

2

FENCE POST MOUNT TO CONCRETE DECK

4

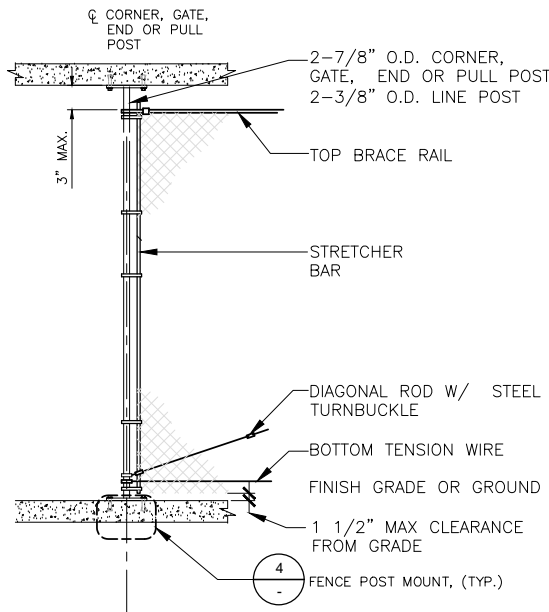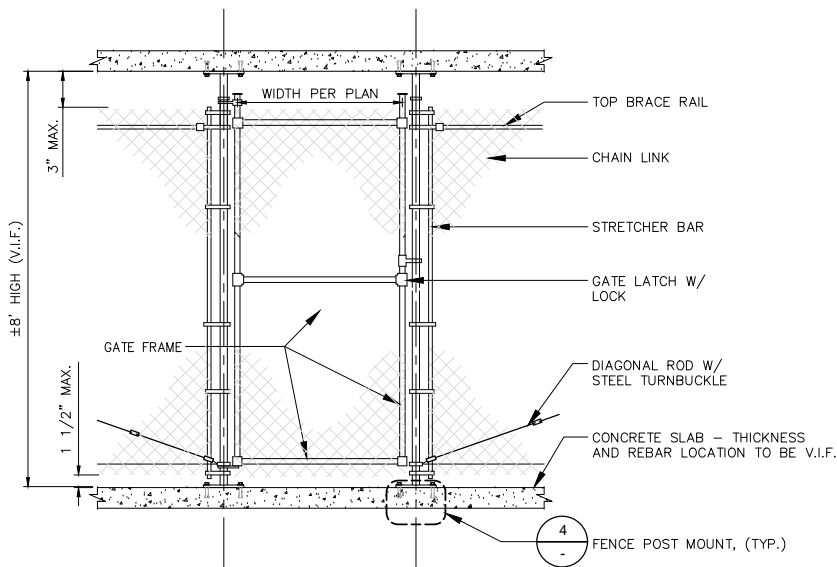

FENCE GATE DETAIL

5

FENCE GATE DETAIL

6

NOT USED

7

APPLICANT:



6591 IRVINE CENTER DRIVE SUITE 100
IRVINE, CA 92618

ENGINEER:



65 POST, SUITE 1000
IRVINE, CA 92618
TEL: (949) 553-8566
www.eukongroup.com

DRAWN BY: TC/EL/CB/JAR
CHECKED BY: JAR

REVISIONS:

REV	DATE	DESCRIPTION
3	01/10/19	DRM COMMENTS
2	08/19/19	PER SITE WALK
1	07/09/19	REDESIGN
0	12/13/17	100% CONSTRUCTION DRAWING
A	10/30/17	90% CONSTRUCTION DRAWING

LICENSER:



EXP. DATE: 12-31-21

DATE SIGNED: 10-23-18

PROJECT INFORMATION:

PACIFICO

LA57XC302


1301 HERMOSA AVE
HERMOSA BEACH, CA 90255

SHEET TITLE:


EQUIPMENT DETAILS

SHEET NUMBER:


A-5.1

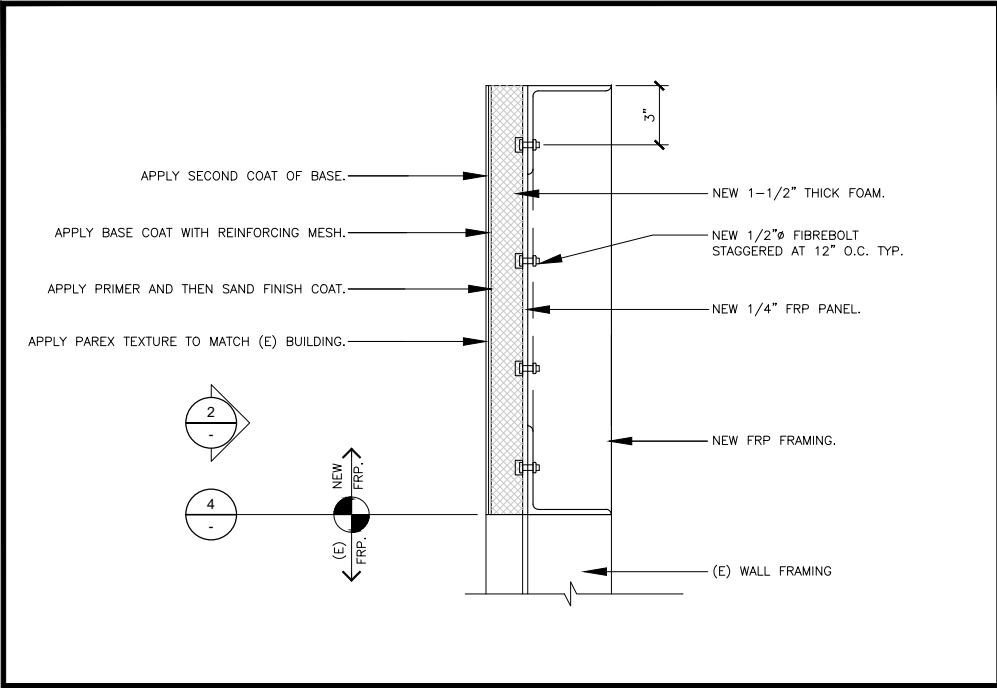





SCREEN WALL SECTION

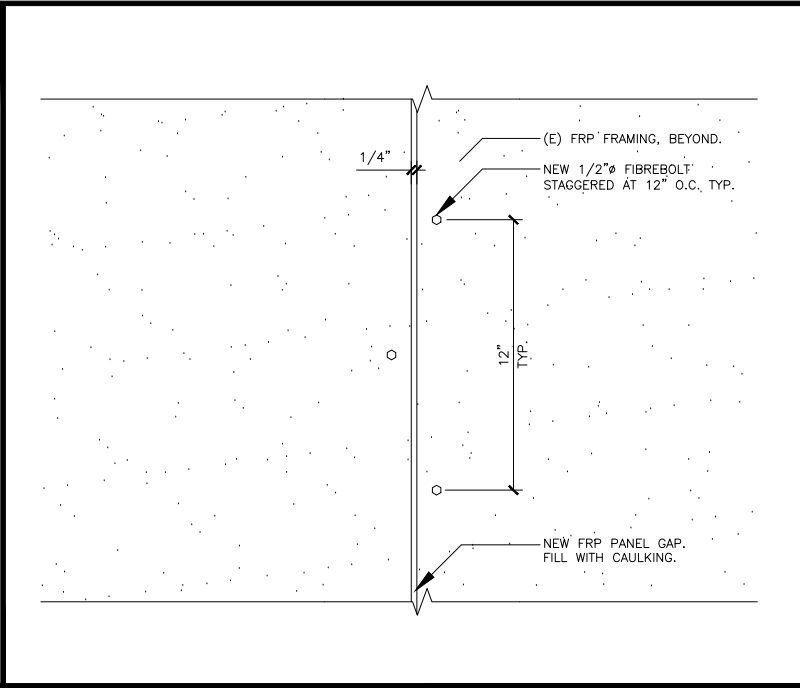

FRP PANEL TO FRP FRAME ELEV

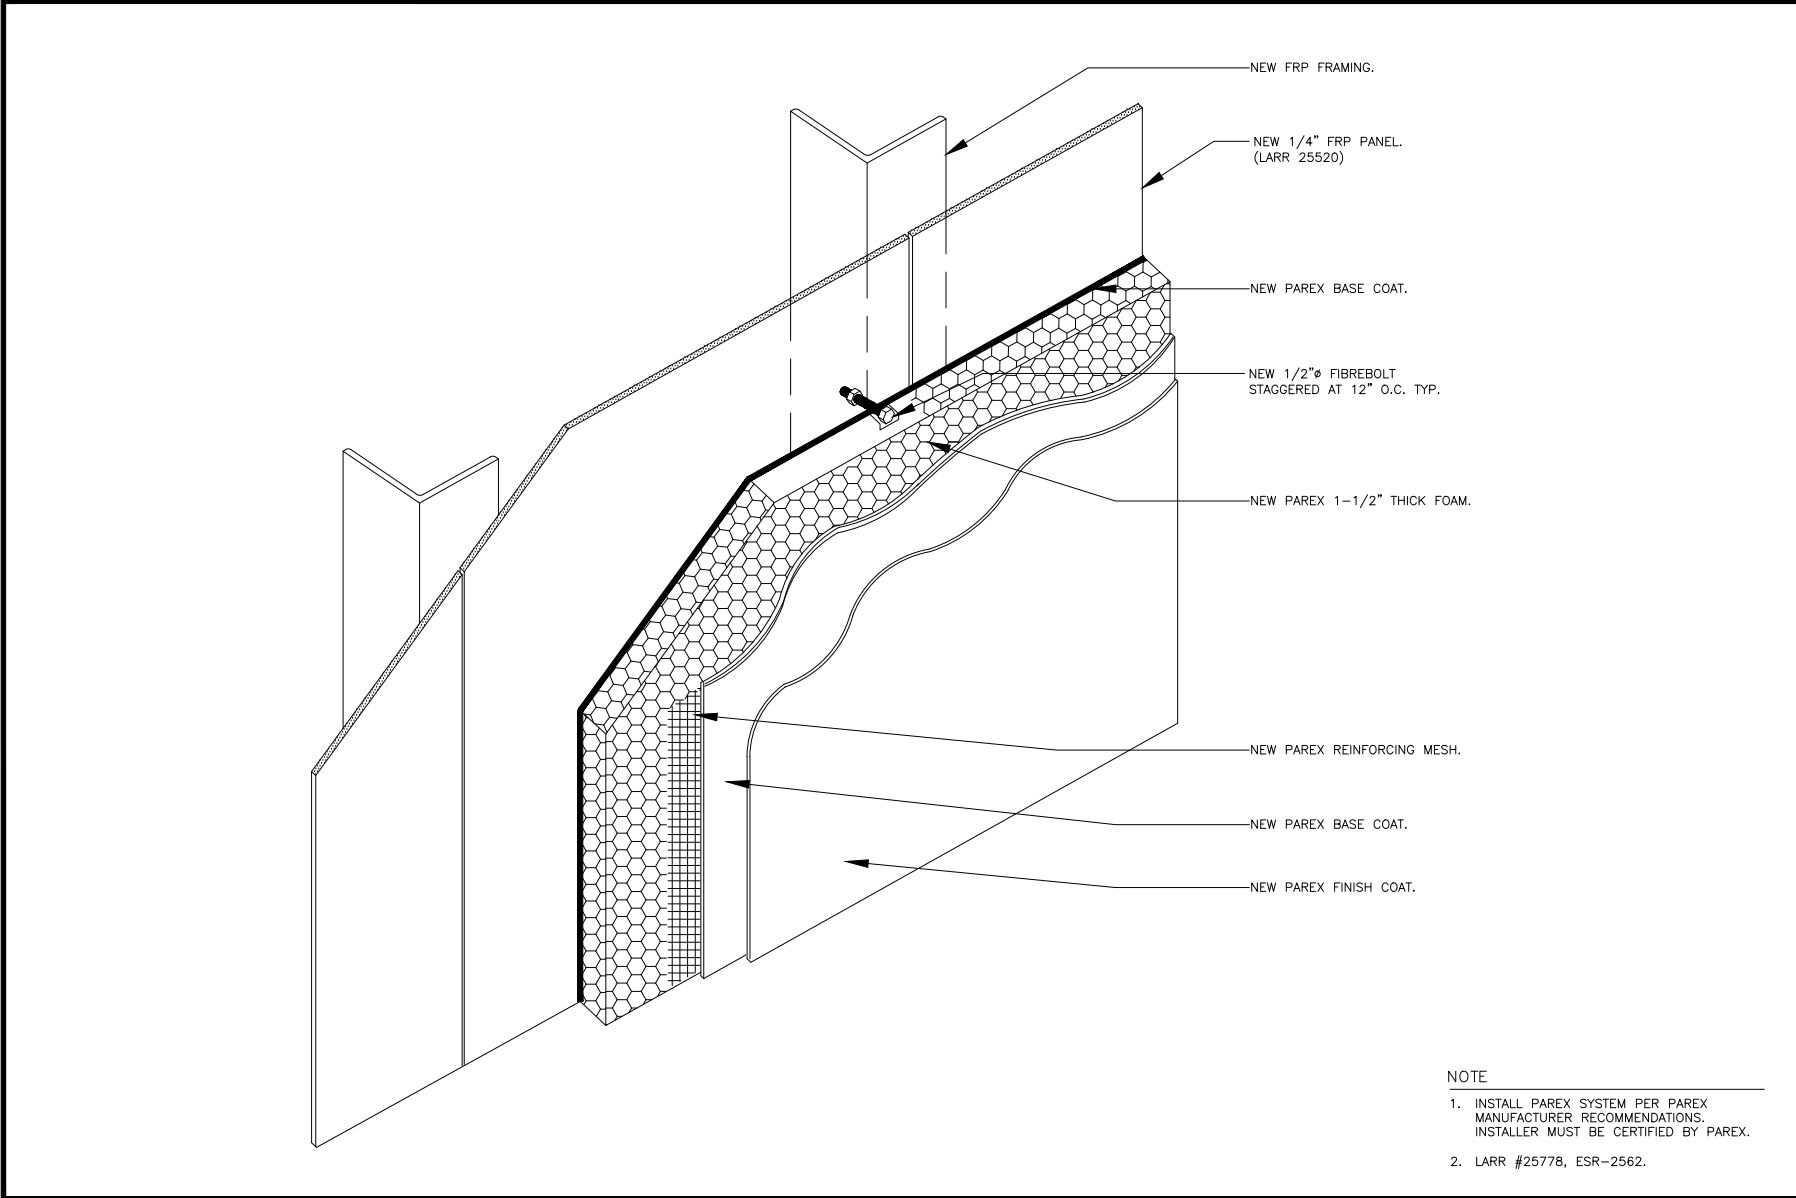

TYPICAL PAREX WALL SYSTEM APPLICATION (ISOMETRIC VIEW)

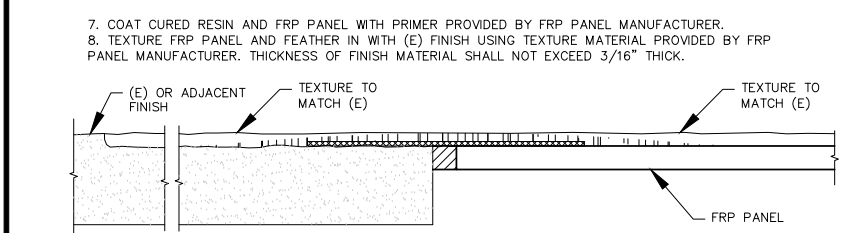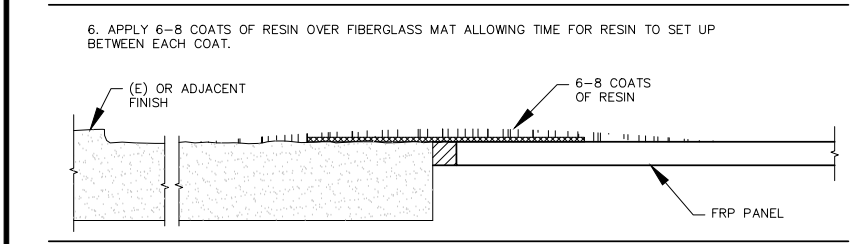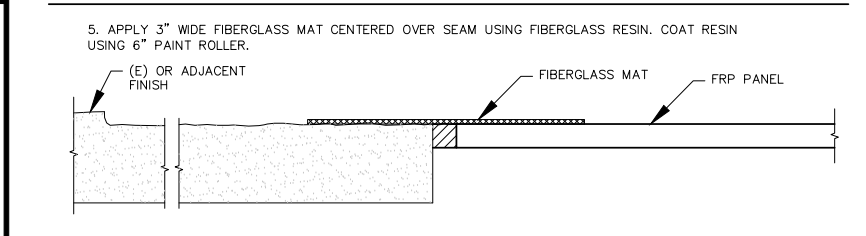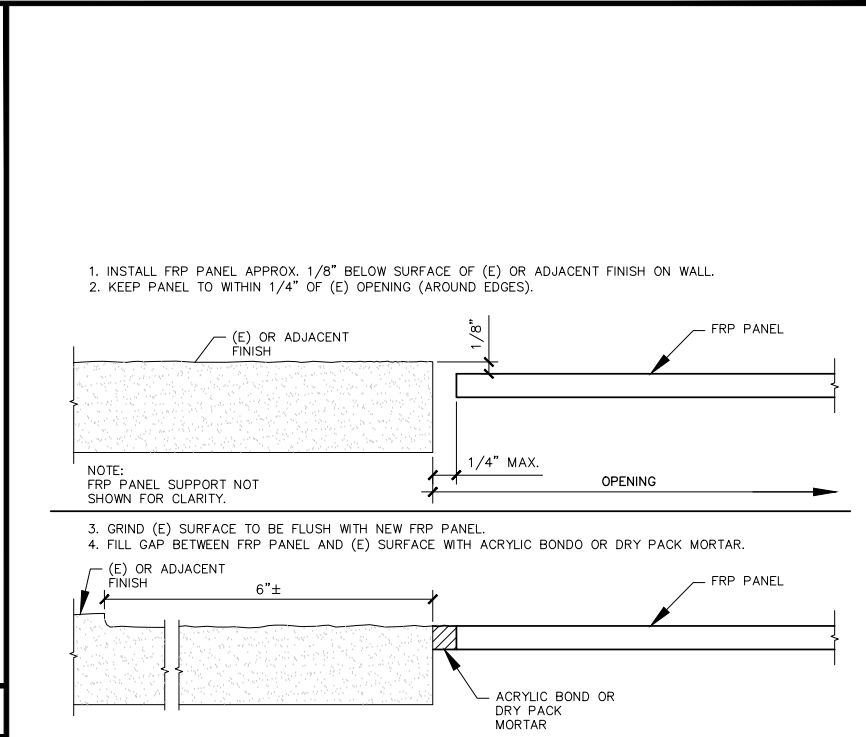

NOTES:
1. TEXTURE AND COLOR OF NEW FRP PANELS TO MATCH (E) BUILDING WALL TEXTURE AND COLOR.
2. FRP SYSTEM SAME FOR ALL SECTORS. CONTRACTOR TO SUBMIT SHOP DRAWINGS TO ARCHITECT PRIOR TO FABRICATION.
3. TEXTURE FRP PANEL AND FEATHER IN FLUSH WITH EXISTING OR ADJACENT FINISH USING TEXTURE MATERIAL PROVIDED BY FRP PANEL MANUFACTURER, SEE DETAIL 3/A-7.1.
4. CONTRACTOR SCOPE TO INCLUDE RE-PAINTING ENTIRE SECTION OF WALLS AS NECESSARY TO OBTAIN CONSISTENT WALL COLORS.

JOINT TREATMENT

APPLICANT:

Sprint

6591 IRVINE CENTER DRIVE SUITE 100
IRVINE, CA 92618

ENGINEER:

Eukon
an SFC Communications, Inc. Company

65 POST, SUITE 1000
IRVINE, CA 92618
TEL: (949) 553-8566
www.eukongroup.com

DRAWN BY: TC/EL/CB/JAR
CHECKED BY: JAR

REVISIONS:		
3	01/10/19	DRM COMMENTS
2	08/19/19	PER SITE WALK
1	07/09/19	REDESIGN
0	12/13/17	100% CONSTRUCTION DRAWING
A	10/30/17	90% CONSTRUCTION DRAWING
REV	DATE	DESCRIPTION

LICENSER:

EXP. DATE: 12-31-21

DATE SIGNED: 10-23-18

PROJECT INFORMATION:

PACIFICO

LA57XC302


1301 HERMOSA AVE
HERMOSA BEACH, CA 90255

SHEET TITLE:


EIFS DETAILS

SHEET NUMBER:


A-6

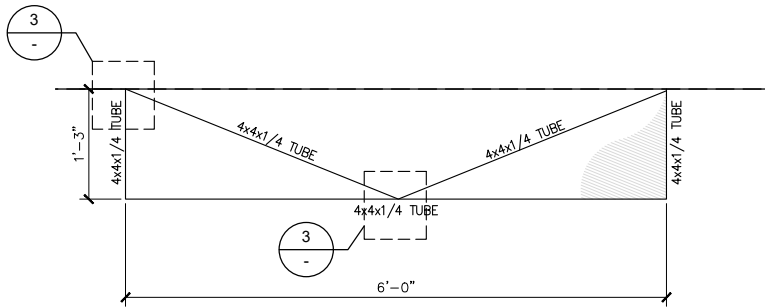

SCREEN FRAMING PLAN (A)

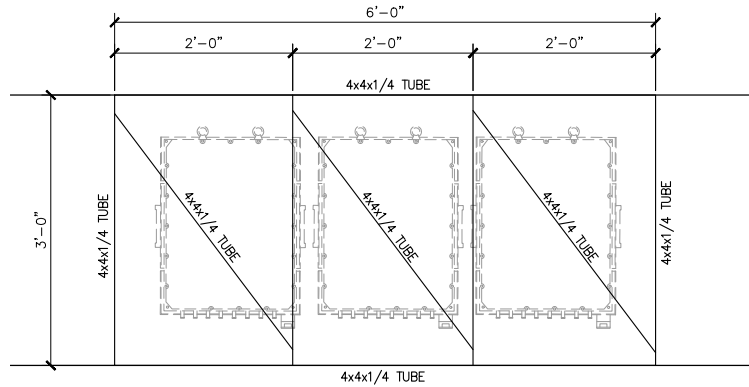

SCREEN FRAMING ELEVATION (B)

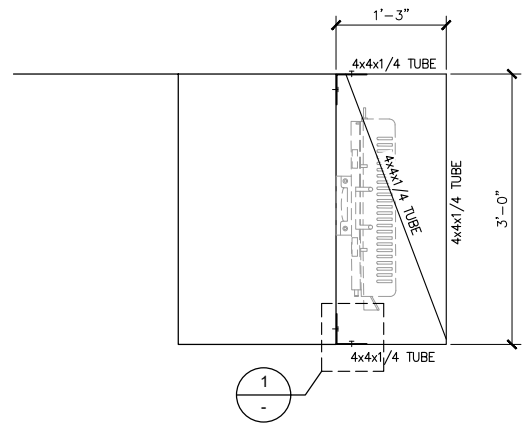


SCREEN FRAMING ELEVATION (C)

SCREEN FRAMING PLAN

2

4x4x1/4" FRP ANGLE BRACE W/
1/2"Ø FRP BOLT CONNECTION TO
FRP TOP PLATE (LARR# 25520)


4x4x1/4" FRP TUBE TOP
PLATE (CONTINUOUS)
(LARR# 25520)

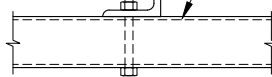

SECTION A-A

4x4x1/4" FRP ANGLE BRACE W/
1/2"Ø FRP BOLT CONNECTION TO
FRP TOP PLATE (LARR# 25520)

4x4x1/4" FRP TUBE TOP
PLATE (CONTINUOUS)
(LARR# 25520)

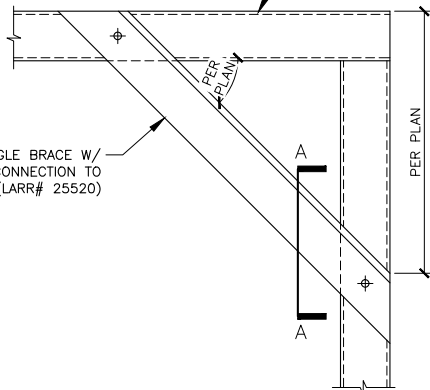


PER PLAN

3/8"Ø HILTI SHOT PINS
WITH 1" EMBEDMENT @ 3'
O.C.

NEW FRP 1/2"Ø THRU BOLTS,
(TYP)

NEW L4x4x1/4 BONDED TO TUBE
SHEET TOP AND BOTTOM

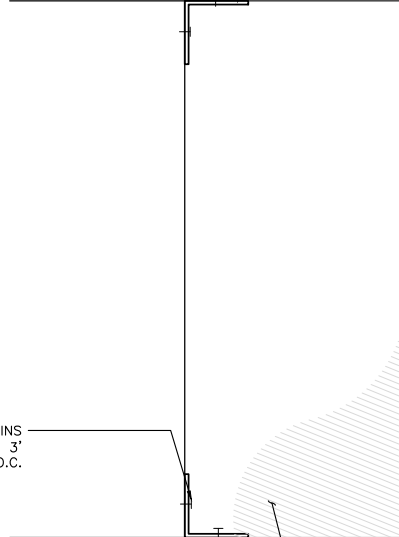

NEW SCREEN BOX. PAINTED
TO MATCH EXISTING
PARKING STRUCTURE

NOT USED

4

SCREEN BRACE CONNECTION

3

ATTACHMENT DETAIL TO PARKING STRUCTURE

1

APPLICANT:

Sprint

6591 IRVINE CENTER DRIVE SUITE 100
IRVINE, CA 92618

ENGINEER:

Eukon
an SFC Communications, Inc. Company

65 POST, SUITE 1000
IRVINE, CA 92618
TEL: (949) 553-8566
www.eukongroup.com

DRAWN BY: TC/EL/CB/JAR
CHECKED BY: JAR

REVISIONS:

REV	DATE	DESCRIPTION
3	01/10/19	DRM COMMENTS
2	08/19/19	PER SITE WALK
1	07/09/19	REDESIGN
0	12/13/17	100% CONSTRUCTION DRAWING
A	10/30/17	90% CONSTRUCTION DRAWING

LICENSER:



EXP. DATE: 12-31-21

DATE SIGNED: 10-23-18

PROJECT INFORMATION:

PACIFICO

LA57XC302


1301 HERMOSA AVE
HERMOSA BEACH, CA 90255

SHEET TITLE:

SCREEN FRAMING
PLAN

SHEET NUMBER:

S-2

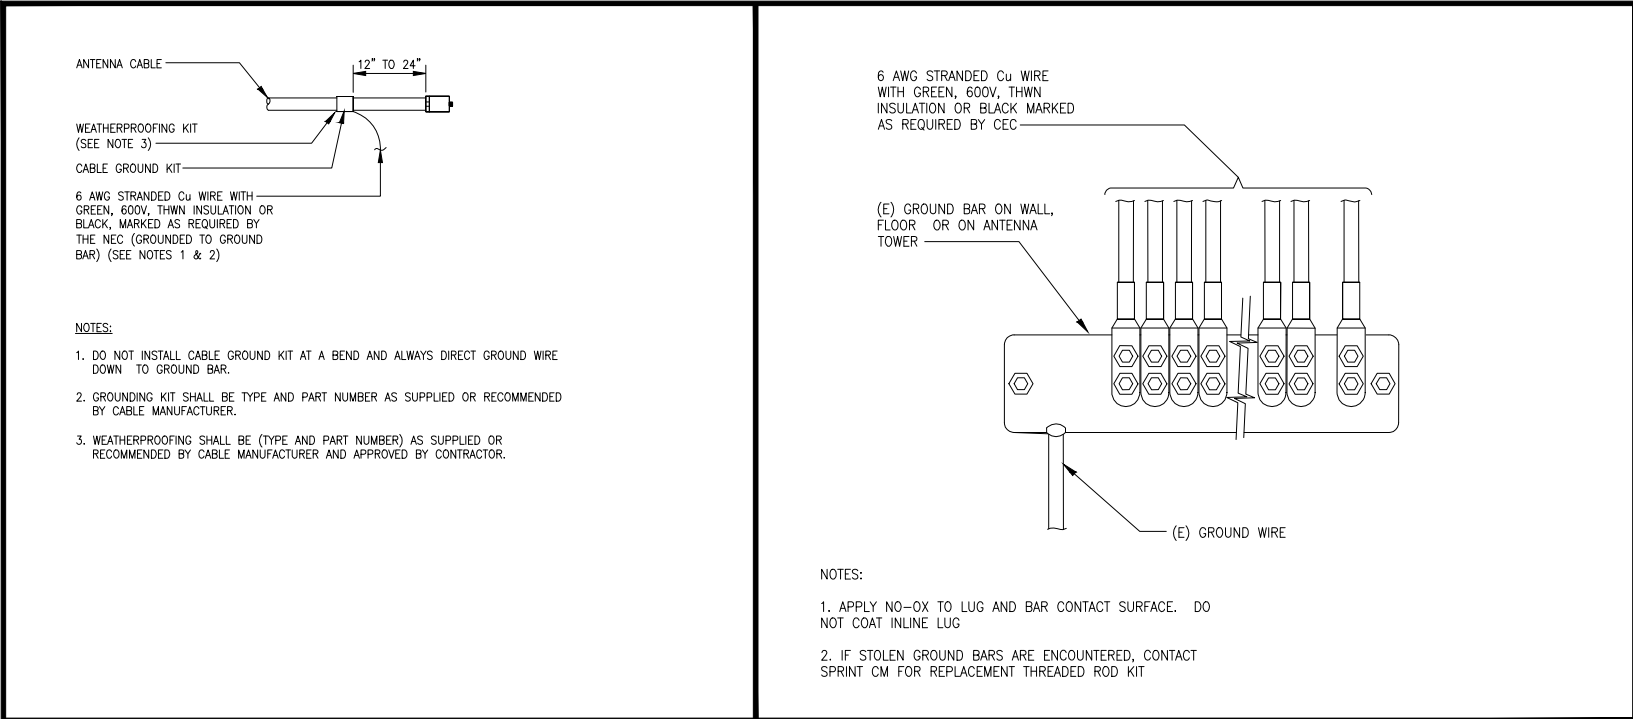

CABLE GROUNDING KIT SPECIFICATION	SCALE NONE	1	GROUND CONDUCTOR SPECIFICATION	SCALE NONE	2
-----------------------------------	---------------	---	--------------------------------	---------------	---

Product Data Sheet

HB114-1-08U4-M5J

RFS

HYBRIFLEX™ RRH Hybrid Feeder Cabling Solution, 1-1/4", Multi-Mode Fiber

Product Description

RFS' HYBRIFLEX Remote Radio Head (RRH) hybrid feeder cabling solution combines optical fiber and DC power for RRHs in a single lightweight aluminum corrugated cable, making it the world's most innovative solution for RRH deployments.

It was developed to reduce installation complexity and costs at Cellular sites. HYBRIFLEX allows mobile operators deploying an RRH architecture to standardize the RRH installation process and eliminate the need for and cost of cable grounding. HYBRIFLEX combines optical fiber (multi-mode or single-mode) and power in a single corrugated cable. It eliminates the need for junction boxes and can connect multiple RRHs with a single feeder. Standard RFS CELLFLEX® accessories can be used with HYBRIFLEX cable. Both pre-connectorized and on-site options are available.

Features/Benefits

- Aluminum corrugated armor with outstanding bending characteristics – minimizes installation time and enables mechanical protection and shielding
- Outer conductor grounding – Eliminates typical grounding requirements and saves on installation costs
- Lightweight solution and compact design – Decreases tower loading
- Robust cabling – Eliminates need for expensive cable trays and ducts
- Installation of tight bundled fiber optic cable pairs directly to the RRH – Reduces CAPEX and wind load by eliminating need for interconnection
- Optical fiber and power cables housed in single corrugated cable – Saves CAPEX by standardizing RRH cable installation and reducing installation requirements
- Outdoor polyethylene jacket – Ensures long lasting cable protection

Technical Specifications


Structure	
Outer Conductor Armor	Corrugated Aluminum (mm (in)) 36.0 (1.42)
Jacket	Polyethylene, PE (mm (in)) 33.0 (1.34)
UV Protection	Individual and External Jacket Yes
Mechanical Properties	
Weight, Approximate	(kg/m (lb/ft)) 1.61 (1.08)
Minimum Bending Radius, Single Bending	(mm (in)) 200 (8)
Minimum Bending Radius, Repeated Bending	(mm (in)) 500 (20)
Recommended/Maximum Cable Spacing	(m (ft)) 1.0 / 1.2 (3.25 / 4.0)
Electrical Properties	
DC-Resistance Outer Conductor Armor	(Ω/km (Ω/1000ft)) 0.9 (0.27)
DC-Resistance Power Cable, 8.4mm² (8AWG)	(Ω/km (Ω/1000ft)) 2.1 (0.54)
Fiber Optic Properties	
Version	Multi-mode
Quantity, Fiber Count	6 pairs
Core/Clad	(μm) 50/125
Primary Coating (Acrylate)	(μm) 245
Buffer Diameter, Nominal	(μm) 500
Secondary Protection, Jacket, Nominal	(mm (in)) 2.0 (0.08)
Standards (Meets or exceeds)	US4440, UL1666, RoHS Compliant
DC Power Cable Properties	
Size	(mm² (AWG)) 8.4 (8)
Quantity, Wire Count	8 (4 pairs)
Type	UV protected
Strands	19
Primary Jacket Diameter, Nominal	(mm (in)) 6.1 (0.24)
Standards (Meets or exceeds)	ICEA S-55-558, ICEA T-29-52.9, UL Type XHHW-2, UL VW-1, IEEE-383 (1974), RoHS Compliant
Environment	
Installation Temperature	(°C (°F)) -40 to +65 (-40 to 149)
Operation Temperature	(°C (°F)) -40 to +65 (-40 to 149)
* This data is provisional and subject to change.	

Figure 1: HYBRIFLEX Series


Figure 2: Construction Detail

RFS The Clear Choice®	HB114-1-08U4-M5J	Rev: P3	Print Date: 28.7.2011
Please visit us on the internet at http://www.rfsworld.com		Radio Frequency Systems	


1- 1/4" FIBER CABLE SPECS	SCALE NONE	3	GROUNDING RISER DIAGRAM	SCALE NONE	4
---------------------------	---------------	---	-------------------------	---------------	---

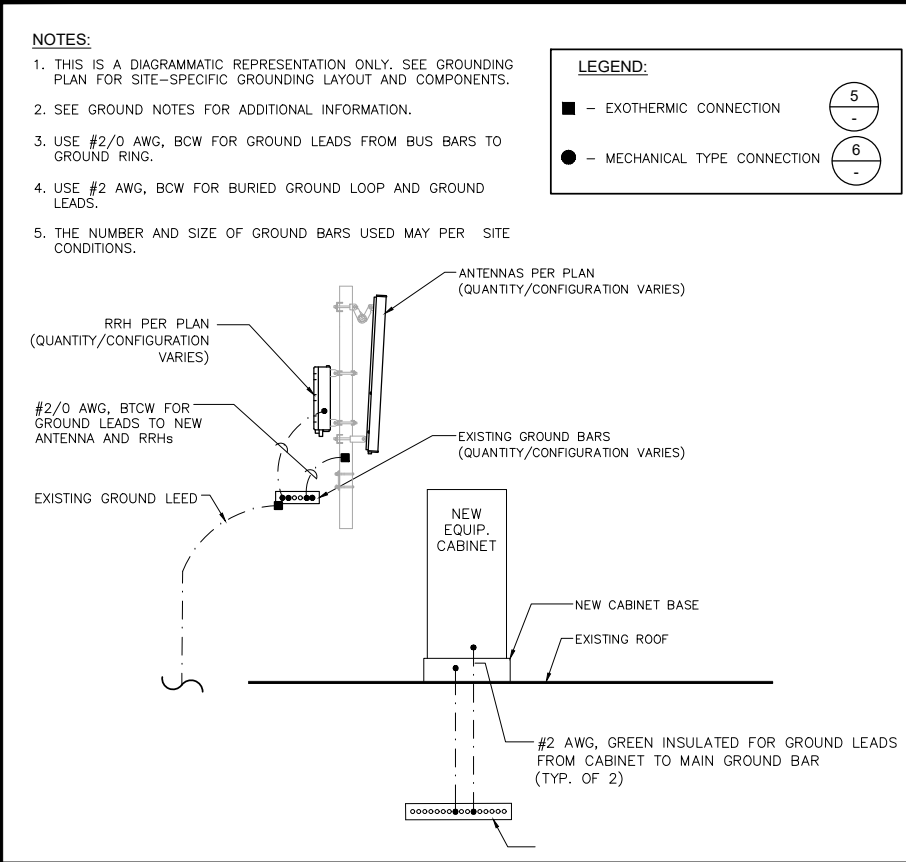

ALU BOX SPECIFICATIONS

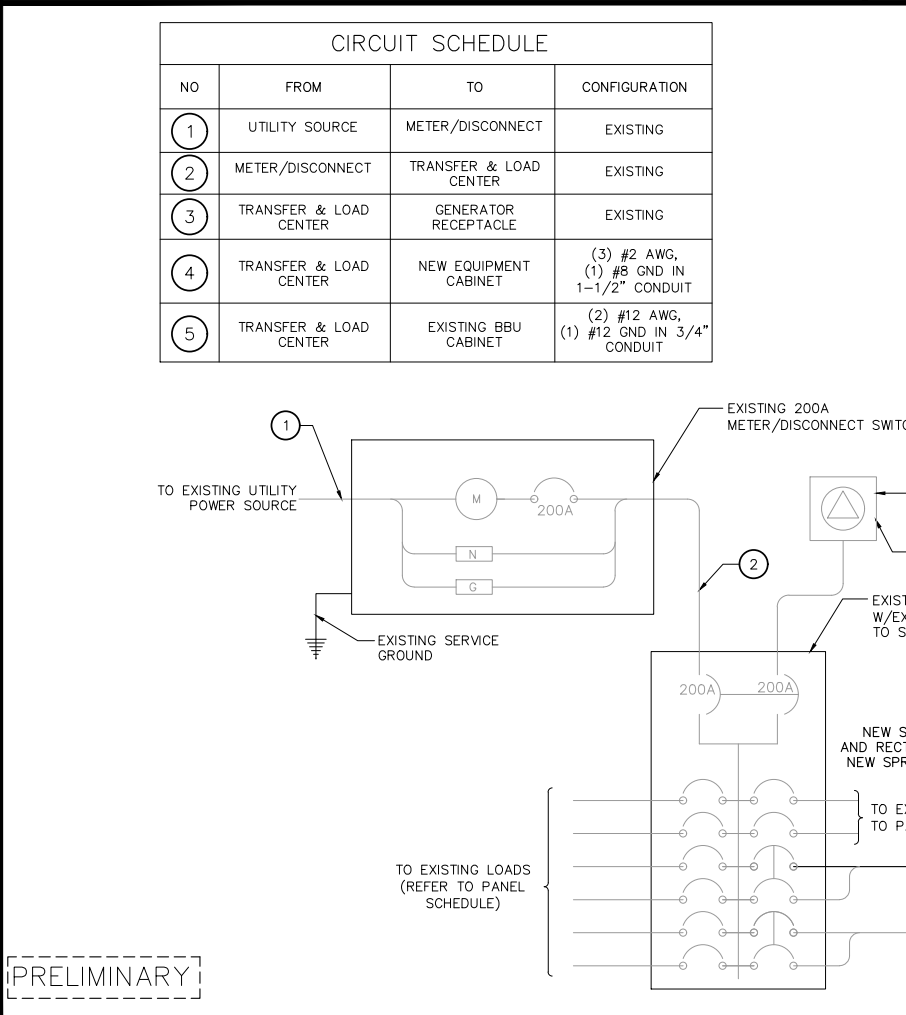


ELECTRICAL ONE-LINE DIAGRAM

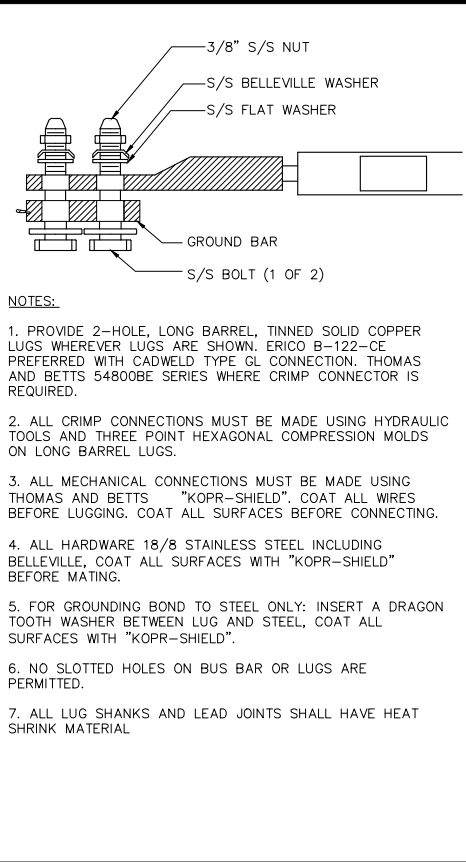


TWO HOLE LUG

1. ALL DETAILS ARE SHOWN IN GENERAL TERMS. ACTUAL GROUNDING INSTALLATION REQUIREMENTS AND CONSTRUCTION ACCORDING TO SITE CONDITIONS.
2. ALL GROUNDING CONDUCTORS: #2 AWG SOLID BARE TINNED COPPER WIRE UNLESS OTHERWISE NOTED.
3. GROUND BAR LOCATED IN BASE OF EQUIPMENT WILL BE PROVIDED, FURNISHED AND INSTALLED BY THE VENDOR.
4. ALL BELOW GRADE CONNECTIONS; EXOTHERMIC WELD TYPE, ABOVE GRADE CONNECTIONS: EXOTHERMIC WELD TYPE.
5. GROUND RING SHALL BE LOCATED A MINIMUM OF 24" BELOW GRADE OR 6" MINIMUM BELOW THE FROST LINE.
6. INSTALL GROUND CONDUCTORS AND GROUND ROD MINIMUM OF 1'-0" FROM EQUIPMENT CONCRETE SLAB, SPREAD FOOTING, OR FENCE.
7. EXOTHERMIC WELD GROUND CONNECTION TO FENCE POST: TREAT WITH A COLD GALVANIZED SPRAY.
8. GROUND BARS: A EQUIPMENT GROUND BUS BAR (EGB) LOCATED AT BOTTOM OF ANTENNA POLE/MAST FOR MAKING GROUNDING JUMPER CONNECTIONS TO COAX FEEDER CABLES SHALL BE FURNISHED AND INSTALLED BY ELECTRICAL CONTRACTOR. JUMPERS (FURNISHED BY OWNERS) SHALL BE INSTALLED AND CONNECTED BY ELECTRICAL CONTRACTOR. B. MAIN GROUND BUS BAR (MGB) LOCATED NEAR THE BASE OF THE RADIO EQUIPMENT CABINETS(S) SHALL BE FURNISHED AND INSTALLED BY ELECTRICAL CONTRACTOR.
9. ALL GROUNDING INSTALLATIONS AND CONNECTIONS SHALL BE MADE BY ELECTRICAL CONTRACTOR.
10. OBSERVE N.E.C. AND LOCAL UTILITY REQUIREMENTS FOR ELECTRICAL SERVICE GROUNDING.
11. GROUNDING ATTACHMENT TO TOWER SHALL BE AS PER MANUFACTURE'S RECOMMENDATIONS OR AT GROUNDING POINTS PROVIDED (2 MINIMUM).
12. IF EQUIPMENT IS IN A C.C FENCE ENCLOSURE, GROUND ONLY CORNER POSTS AND SUPPORT POSTS ON GATE. IF CHAIN LINK LID IS USED, THEN GROUND LID ALSO.
13. GROUNDING @ PPC CABINET SHALL BE VERTICALLY INSTALLED.
14. ALL GROUNDING FOR ANTENNAS SHALL BE CONNECTED SO THAT IT WILL BY-PASS MAIN BUSS BAR.
15. ALL EMT RUNS SHALL BE GROUNDED AND HAVE A BUSHING. NO PVC ABOVE GROUND.
16. USE SEPARATE HOLES FOR GROUNDING @ BUSS BAR. NO "DOUBLING-UP" OF LUGS.
17. POWER AND TELCO CABS. SHALL BE GROUNDED (BONDED) TOGETHER.
18. NO "LB'S" ALLOWED ON GROUNDING RUNS.
19. PROVIDE STAINLESS STEEL CLAMP AND BRASS TAGS ON COAX @ ANTENNAS AND DOGHOUSE.


GROUNDING NOTES

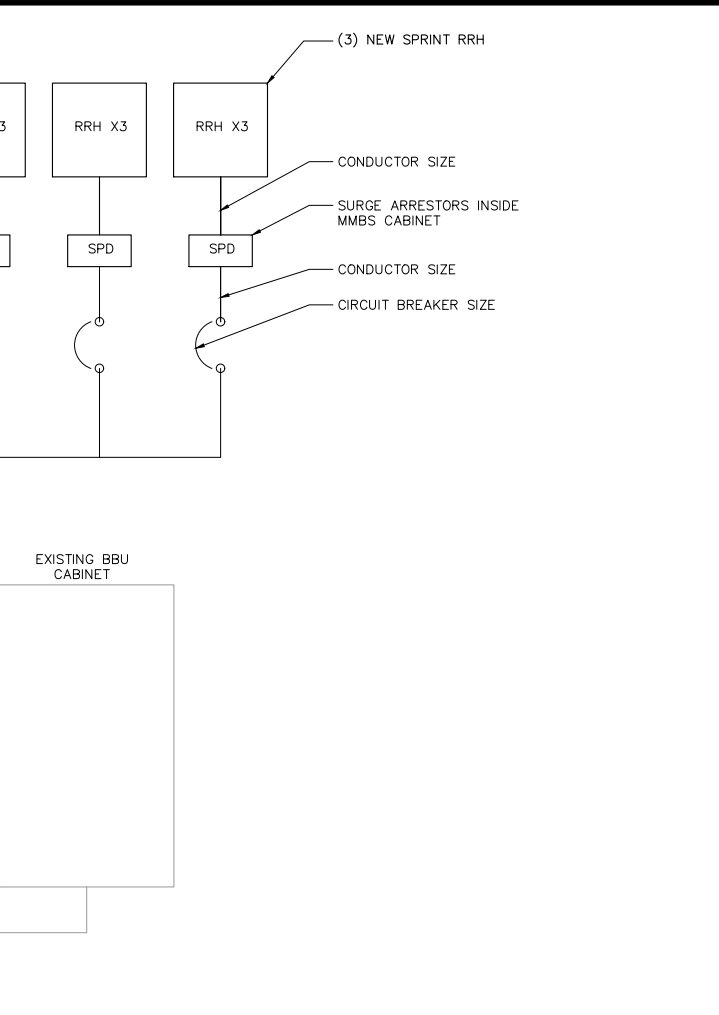

NOT USED

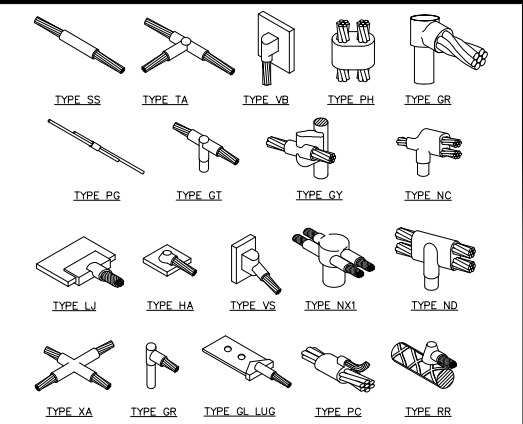

EXOTHERMIC CONNECTIONS

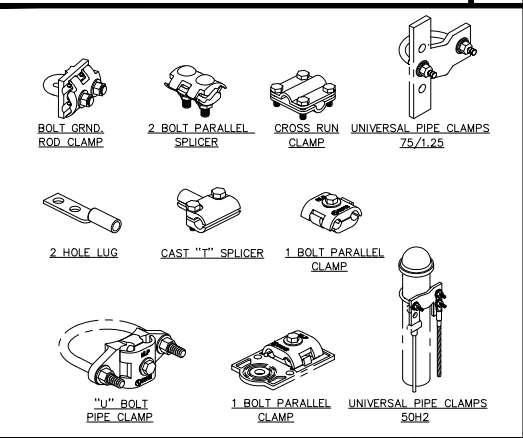

MECHANICAL CONNECTIONS



NOT USED

APPLICANT:

Sprint

6591 IRVINE CENTER DRIVE SUITE 100
IRVINE, CA 92618

ENGINEER:

Eukon
an SFC Communications, Inc. Company

65 POST, SUITE 1000
IRVINE, CA 92618
TEL: (949) 553-8566
www.eukongroup.com

DRAWN BY: TC/EL/CB/JAR
CHECKED BY: JAR

REVISIONS:		
3	01/10/19	DRM COMMENTS
2	08/19/19	PER SITE WALK
1	07/09/19	REDESIGN
0	12/13/17	100% CONSTRUCTION DRAWING
A	10/30/17	90% CONSTRUCTION DRAWING
REV	DATE	DESCRIPTION

LICENSER:

EXP. DATE: 12-31-21

DATE SIGNED: 10-23-18

PROJECT INFORMATION:

PACIFICO

LA57XC302

1301 HERMOSA AVE
HERMOSA BEACH, CA 90255

SHEET TITLE:

ONE-LINE DIAGRAM /
GROUNDING DETAILS

SHEET NUMBER:

E-1