


8		10			2   13	)	(15)	6 SIDEWALK
		115'-10		CENTE			     	A8.3
CENTER LINE OF GUEST ROOM WALL	25'-0"		5.90 ≸TH ET	3!-3"···		) - * * * * * * * * * * * * * *		1p'-0"
			<u>16.20</u> F.S.			YP:		5' LANDSCAPE AREA
						3 	16.30 <del>16</del> 30 F.S.	
<u>.10</u> D.GRATE		T.O.GI STANDARD P 18'-0" x 8	ARKING	CLEA /ANP(		36	CHARGING	
<u> </u>						STANDARD PARKING 18'-0" x 8'-6" 		
			_					DESK / CHECK-IN
	ROLL-UP					STANDARD PARKING		
			8-6"	AN A		• 		1B A10.6
<u> </u>								
	   -	8'-6"						
·	· · · · · · · · · · · · · · · · · · ·	│ <del>∦  </del> ┿ - ┝ ━━━ -	8-6"	LEAN VPQC		STANDARD PARKING	─────│┱╢┢┼┼─	
		STANDARD PAP 18'-0" x 8'-6		AIR/ )L/EV	22	18'-0" x 8'-6"		
	25'-0"			/3		18'-0"		
	DRIVEWAY		    -96			7-8"		
•	2	36	•     	23		ACCESSIBLE PARKING 18'-0" x 9'-6"		
	· · · · · ·	↓_L						1 16.30 F.F.EL.
		7 DA2			ZD	bi ()		
				KING				
	_		   					PF-01 PF-03 PC-03
	GARAGE				¦			
			6 -9-6			● ACCESSIBLE ♀ PARKING 18'-0" x 9'-6"		
	18-0				   			
				<b></b>	 <del> -</del>	     		
		STANDARD PARK 18'-0" x 8'-6"	(ING 1.2			IPACT PARKING 15'-0" x 7'-6"		
		+		25-	 		5'-9"	
								-+-r
			7'-8"		   	COMPACT PARKING		$\begin{bmatrix} 1 \\ 1 \\ A10.5 \end{bmatrix}$
			2	26	   		27	15'-0" x 7'-6"
		STANDARD PA 18'-0" x 8'-			   	15'-0"		
   	25'-0"		40'-0" 7'-4"		   			COMPACT PARKI 15'-0" x 7'-6"
		8'-6"		28	   	15'-0" x 7'-6"		29
·		+ + - 34						
	-		7'-6"		   	COMPACT PARKING 15'-0" x 7'-6"		COMPACT PARKII 15'-0" x 7'-6"
TRASH AREA ROLL-UP DOOR		<u>-UP</u> AGE DOOR			   			
	DRIVEWAY		7'-6"		   	COMPACT PARKING 15'-0" x 7'-6"		15'-0" x 7'-6" 1/2" MAX. THRESHOLD
42 D.GRATE		T.O.GF	15.57 RATE				(33)	
F	IFTEENTH COU	IRT		1 <u>5.60</u> GL		(31) <sub>TYP.</sub>		SLOPE SLAB TO STREET
	25'-0"	 	0"	<u>}</u>   	 	3 	0'-6"	
CENTER LINE OF GUEST ROOM WALL		GUEST ROOM W		CENTER LINE OF COLUMN CENTER	LINE OF COLUMN		CENTER LINE OF GUEST ROOM WA	
			A A7.1		L .			6 A8.3

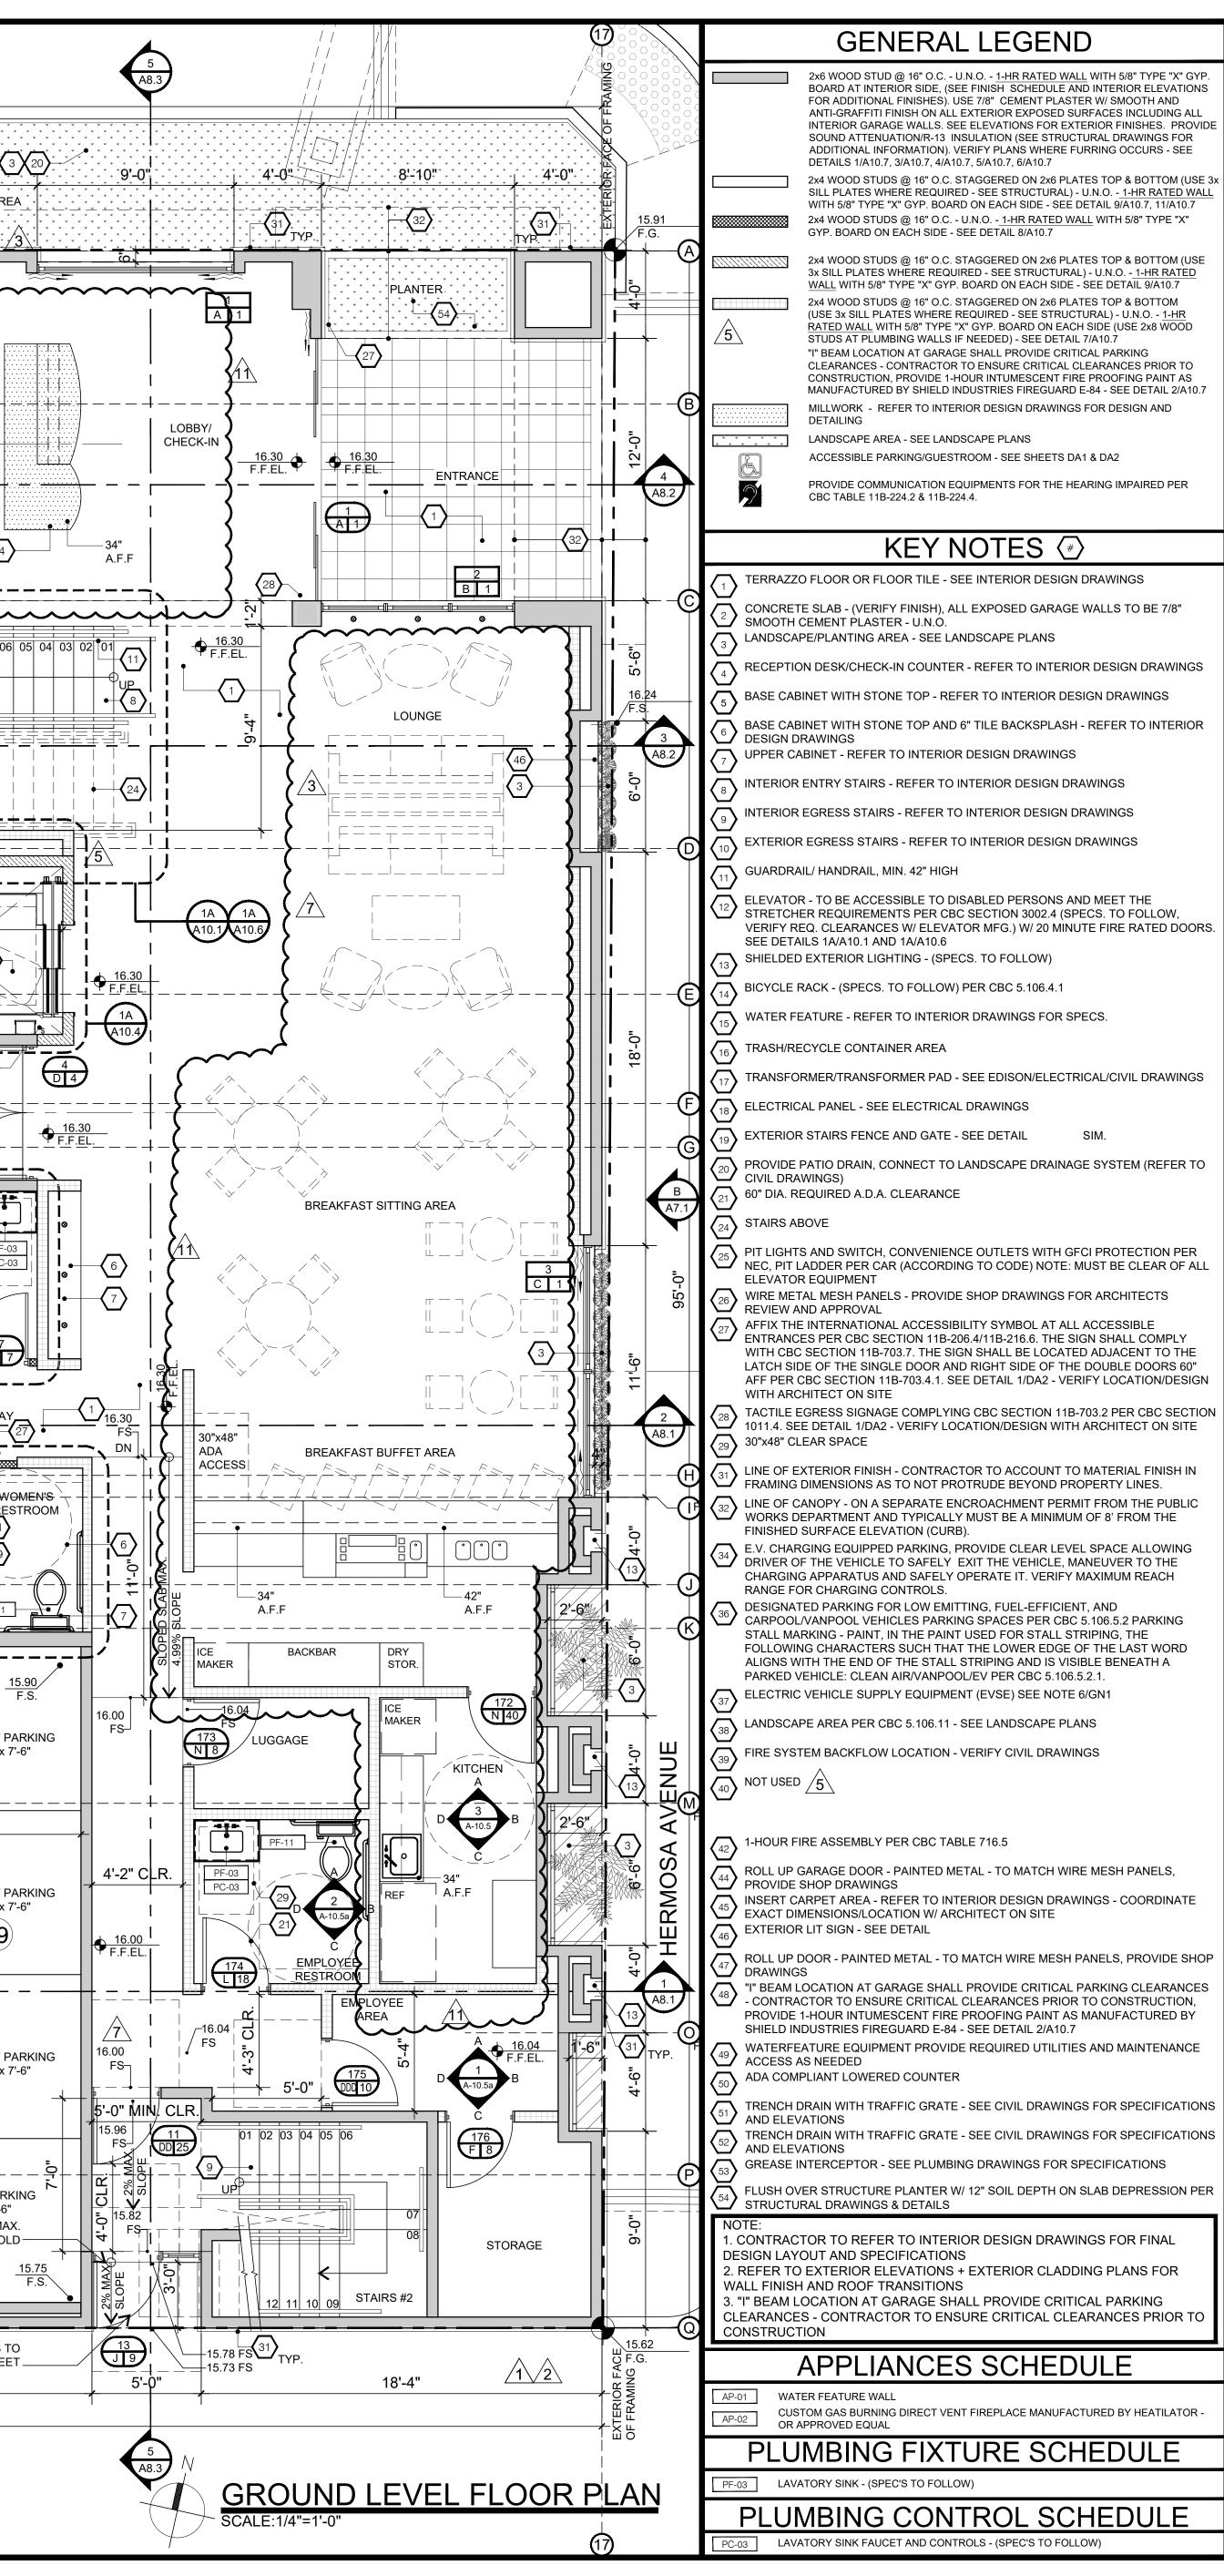

TOP & BOTTOM (USE 3x	
I.O <u>1-HR RATED WALL</u> AIL 9/A10.7, 11/A10.7 WITH 5/8" TYPE "X"	
TOP & BOTTOM (USE J.N.O <u>1-HR RATED</u> E DETAIL 9/A10.7	
TOP & BOTTOM AL) - U.N.O <u>1-HR</u> DE (USE 2x8 WOOD 10.7	
PARKING RANCES PRIOR TO ROOFING PAINT AS	INTERIOR DESIGN 13101 WASHINGTON BOL
4 - SEE DETAIL 2/A10.7 R DESIGN AND	LOS ANGELES, CALIFC 310-379-971 e-mail: luis@envirote website: envirotech
DA2	▲ 08/05/2015 ゑ 12/15/2015
NG IMPAIRED PER	<ul> <li>▲ 03/21/2016</li> <li>▲ 10/10/2016</li> </ul>
AWINGS	<ul> <li>▲ 11/09/2016</li> <li>▲ 12/19/2016</li> <li>▲ 05/23/2017</li> </ul>
AWINGS ALLS TO BE 7/8"	<ul> <li>▲ 08/30/2017</li> <li>▲ 09/21/2017</li> <li>▲ 10/25/2017</li> </ul>
DESIGN DRAWINGS	<u>A</u> 07/22/2020
N DRAWINGS EFER TO INTERIOR	
INGS WINGS	
WINGS	
MEET THE S. TO FOLLOW, FIRE RATED DOORS.	RMOSA BOUTIQ HOTEL, LLC
S.	EL, L BC A BC A BC
L/CIVIL DRAWINGS	<b>HOS</b> ICHHABI
И. SYSTEM (REFER TO	HERV HERV F
PROTECTION PER ST BE CLEAR OF ALL	CLIEN
CESSIBLE SHALL COMPLY DJACENT TO THE DUBLE DOORS 60" ( LOCATION/DESIGN	Ш Н
.2 PER CBC SECTION CHITECT ON SITE	SA HO
ATERIAL FINISH IN ERTY LINES. FROM THE PUBLIC F 8' FROM THE	N N N N N
PACE ALLOWING EUVER TO THE KIMUM REACH	
ND 06.5.2 PARKING 'ING, THE 'HE LAST WORD	
E BENEATH A 1. N1	
	PROJ
,	AN
	ЪГ
IESH PANELS,	0 R
GS - COORDINATE	FLOOR
ELS, PROVIDE SHOP	_
RKING CLEARANCES CONSTRUCTION, NUFACTURED BY	EVEL
ND MAINTENANCE	
OR SPECIFICATIONS	GROUND
OR SPECIFICATIONS	
AB DEPRESSION PER	B B B B B B B B B B B B B B B B B B B
S FOR FINAL	JOB NO: DATE:
B PLANS FOR	SCALE: DRAWN BY: CHECKED BY:
ANCES PRIOR TO	SHEET NO:
EDULE	<b>A</b> 3

310	NVIRO         INTERACTIVE ARC         INTERIOR D         INTO D     <	HITEC DESIGN ALIFC 9-971 virote rotech 015 015 016 016 016 016 016 017 017 017	TURE I ILEV DRNI 6 chnc	E + ARD, A 900 D.com	#40
CLIENT NAME:	HERMOSA BOUTIQU HOTEL. LLC	RAJU CHHABRIA & RHAVI KHOSLA	205 PIER AVENUE, SUITE 201	HERMOSA BEACH, CA 90254	
PROJECT TITLE:	HERMOSA BOLITIONE HOTEL		1429 HERMOSA AVENUE	HERMOSA BEACH, CA 90254	
	FLOOR PLAN				- 12/01/2017

0012-03

09-17-12

ENM

LDM

AS NOTED

EQUIP	MENT SCHEDULE		
EQUIPM	IENT		
ITEM	DESCRIPTION	QTY	MAKE/MODEL
1	BAR TOP AND DIE	1 LOT	CUSTOM MILLWORK
2	BAR SINK	1	PERLICK #TSD53C
3	BAR HAND SINK	1	PERLICK #TS12HSN
4	DRAINBOARD	1	PERLICK #SC12
5	BLENDER STATION	1	PERLICK #TS12BLW
6	BAR BLENDER	1	HAMILTON BEACH #950
7	JOCKEY BOX	1	PERLICK #TS24IC10
8	SPARE NUMBER		
9	SPARE NUMBER		
10	POS TERMINAL	1	
11	BACK BAR WINE COOLER	1	PERLICK #DZS60
12	ESPRESSO GRINDER	1	NUOVA SIMONELLI #G60
13	ESPRESSO MACHINE	1	NUOVA SIMONELLI #MUSICA
14	BACK BAR COOLER	1	PERLICK #BBS60
15	BACK BAR COUNTER	1 LOT	CUSTOM MILLWORK
16	SPARE NUMBER		
17	SHELVING	1	METRO #NK3 SERIES
18	ICE MAKER	1	HOSHIZAKI #KM-901MAJ
19	ICE BIN	1	HOSHIZAKI #B-500-PF
20	WORKTABLE	1	CUSTOM ST/ST
21	COFFEE MAKER	1	CURTIS #D500GT63A000
22	COFFEE GRINDER	1	CURTIS #SHG-10
23	REACH IN REFRIGERATOR	1	HOSHIZAKI #R2A-FG

x 8'-6"			
<b>12.</b> 37		RECEPTION DESK /	LOBBY/ CHECK-IN
		CHECK-IN	$\begin{cases} \frac{16.30}{\text{F.F.EL.}} \mathbf{\Phi} \end{cases}$
PARKING		DESK / CHECK-IN	}
		34"	ξ.
		A.F.F	
			16.30 ↓ 16.50 ↓ F.F.EL.
	(49)		<b>7</b>   !
6	·—···		
PARKING 8'-6"			
<u>_</u>			
0"		9'-8"	
7'-8"		ו (12)	A10.1 A10.6
		◆ <u>16.3</u>	0   L.
ACCESSIBLE PARKING 18'-0" x 9'-6"			
			<b>7</b>
		16.30 F.F.EL.	
		1 1 27 4 16.30 F.F.EL.	
	16.30	A10.5	
$\left( \right) \left( \frac{1}{\sqrt{37}} \right)$			
			E
Ę	φ α	21 PF-03 PC-03	
EV CHARGING STATION			
CCESSIBLE C		21 PF-03 PC-03 MEN'S RESTROOM 7	
PARKING 18'-0" x 9'-6"			
;	1 1 1 1 1 1 1 1 1 1 1 1 1 1 1 1 1 1 1 1		
	4	G 11 HALLWAY / 16.30 FS- DN	6 (3) 30"748" 5 4 ADA
+++			ADA ACCESS
167 ZZ[38	MECHANICAL ROOM	B B C C C C C C C C C C C C C	42"
ING _9-			
<u>ω</u>	<del>۲</del> <u>5'-9</u> "		
		<sup>1</sup> ****	╍╉ <sub>┪╸╊╤┥</sub> ┠╱┛╌╴╴╴╴┼╶╷╴╴╴╴┼╶╴╴╴┼
1			
T COMPACT PARKING 15'-0" x 7'-6"		(1) F.S. (A10.5) F.S. (16.00) FS	
		$\left(\frac{1}{10.5}\right)$ F.S.	
	27	COMPACT PARKING	
	27)	COMPACT PARKING	16.04 FS 173 LUGGAGE
	27)	1     F.S.       A10.5     F.S.       COMPACT PARKING     16.00       15'-0" x 7'-6"	16.04 FS UGGAGE
15'-0" x 7'-6" COMPACT PARKING	27) 53	1       F.S.         A10.5       F.S.         COMPACT PARKING       16.00         15'-0" x 7'-6"       FS         15'-0"       4'-2"         COMPACT PARKING       4'-2"	16.04 FS 173 LUGGAGE
15'-0" x 7'-6"		1       F.S.         A10.5       F.S.         COMPACT PARKING       16.00         15'-0" x 7'-6"       FS         15'-0"       4'-2"         COMPACT PARKING       15'-0" x 7'-6"	CLR. PF-03 PC PC-03 PC PC PC PC PC PC PC PC PC PC PC P
15'-0" x 7'-6" COMPACT PARKING		1       F.S.         A10.5       F.S.         COMPACT PARKING       16.00         15'-0" x 7'-6"       FS         15'-0"       4'-2"         COMPACT PARKING       4'-2"	CLR. PF-03 PC-
COMPACT PARKING		1       F.S.         A10.5       F.S.         COMPACT PARKING       16.00         15'-0" x 7'-6"       FS         15'-0"       4'-2"         COMPACT PARKING       15'-0" x 7'-6"	CLR. PF-03 PC-03 Cl.R. PF-04 Cl.R. PF-04 Cl.R. PF-03 PC-03 Cl.R. PF-04 Cl.R. P
15'-0" x 7'-6" COMPACT PARKING		$ \begin{array}{c} 1 \\ A10.5 \\ COMPACT PARKING \\ 15'-0" \times 7'-6" \end{array} $ 16.00 FS 16.00 FS 15'-0" 4'-2" COMPACT PARKING 15'-0" \times 7'-6" 29 $ \begin{array}{c} 4'-2" \\ \hline & & & & \\ \hline & & & & \\ \hline & & & & \\ \end{array} $	CLR. $PF-03$ PF-03 PF-11 PF-03 PF-11
15'-0" x 7'-6" COMPACT PARKING 15'-0" x 7'-6"		1       F.S.         A10.5       F.S.         COMPACT PARKING       16.00         15'-0" x 7'-6"       FS         15'-0"       4'-2"         COMPACT PARKING       15'-0" x 7'-6"	C = R. $PF-03$ $PF-11$ $PF-03$ $PF-11$ $PF-11$ $PF-03$ $PF-11$ $PF-$
15'-0" x 7'-6"		$1 \\ A10.5$ F.S. $10.00$ 16.00 $15'-0" \times 7'-6"$ $4'-2"$ $16.00$ $5$ $15'-0" \times 7'-6"$ $4'-2"$ $16.00$ $5$ $16.00$ $5$ $16.00$ $5$ $16.00$ $5$ $16.00$ $5$ $15'-0" \times 7'-6"$ $16.00$ $5'-0" \times 7'-6"$ $16.00$	CLR. $PF-03$ PF-03 PF-11 PF-11 PF-03 PC-03
15'-0" x 7'-6" COMPACT PARKING 15'-0" x 7'-6"		$1 \\ A10.5$ F.S. $10.00$ 16.00 $15'-0" \times 7'-6"$ $4'-2"$ $16.00$ $5$ $15'-0" \times 7'-6"$ $4'-2"$ $16.00$ $5$ $16.00$ $5$ $16.00$ $5$ $16.00$ $5$ $16.00$ $5$ $15'-0" \times 7'-6"$ $16.00$ $5'-0" \times 7'-6"$ $16.00$	CLR. PF-03 PC-
15'-0" x 7'-6" COMPACT PARKING 15'-0" x 7'-6"		$ \begin{array}{c} 1 \\ A10.5 \\ COMPACT PARKING \\ 15'-0" \times 7'-6" \end{array} $ $ \begin{array}{c} 4'-2" \\ COMPACT PARKING \\ 15'-0" \times 7'-6" \\ \hline 29 \\ \hline 16.00 \\ F.F.E \\ \hline 16.00 \\ F.F.E \\ \hline 5'-0" \\ 15.96 \\ F.S \\ \hline 5'-0" \\ \hline 15.96 \\ F.S \\ \hline 5'-0" \\ \hline 5'-0$	CLR. PF-03 PC-
15'-0" x 7'-6" COMPACT PARKING 15'-0" x 7'-6" COMPACT PARKING 15'-0" x 7'-6"		$ \begin{array}{c} 1 \\ A10.5 \\ COMPACT PARKING \\ 15'-0" \times 7'-6" \end{array} $ $ \begin{array}{c} 4'-2" \\ COMPACT PARKING \\ 15'-0" \times 7'-6" \\ \hline 29 \\ \hline 16.00 \\ F.F.E \\ \hline 16.00 \\ F.F.E \\ \hline 5'-0" \\ 15.96 \\ F.S \\ \hline 5'-0" \\ \hline 15.96 \\ F.S \\ \hline 5'-0" \\ \hline 5'-0$	C.R. PF-03 PC-
15'-0" x 7'-6" COMPACT PARKING 15'-0" x 7'-6" COMPACT PARKING 15'-0" x 7'-6"		1       A10.5       F.S.         COMPACT PARKING       16.00         15'-0" x 7'-6"       4'-2"         COMPACT PARKING       15'-0" x 7'-6"         29       16.00         F.F.E       16.00         F.F.E       5'-0" x 7'-6"         COMPACT PARKING       16.00         F.F.E       16.00         F.F.E       5'-0" M         COMPACT PARKING       5'-0" M         15.96       FS         5'-0" M       5'-0" M         15.96       FS         5'-0" M       5'-0" M         15.96       FS         5'-0" M       5'-0" M	CLR. PF-03 PC-03 PF-11 CLR. PF-03 PC-0
15'-0" x 7'-6" COMPACT PARKING 15'-0" x 7'-6" COMPACT PARKING 15'-0" x 7'-6"		1       1       F.S.       16.00         COMPACT PARKING       15'-0" x 7'-6"       4'-2"         15'-0"       29       4'-2"         COMPACT PARKING       15'-0" x 7'-6"       16.0         15'-0" x 7'-6"       29       16.0         COMPACT PARKING       15'-0" x 7'-6"       16.00         F.F.E       0       16.00         COMPACT PARKING       15'-0" x 7'-6"       16.00         FS       0       F.F.E         COMPACT PARKING       15'-0" x 7'-6"       15.00         FS       5'-0" N       15.96         FS       15'-0" x 7'-6"       15.8         15'-0" x 7'-6"       15.8       15.8         15'-0" x 7'-6"       15.75       15.8	CLR. PF-03 PC-03 PF-11 CLR. PF-03 PC-0
15'-0" x 7'-6" COMPACT PARKING 15'-0" x 7'-6" COMPACT PARKING 15'-0" x 7'-6"		1       F.S.         10.5       F.S.         16.00       FS         15'-0" x 7'-6"       4'-2"         COMPACT PARKING       15'-0" x 7'-6"         29       16.0         F.F.E       16.0         COMPACT PARKING       16.0         15'-0" x 7'-6"       16.0         29       16.0         F.F.E       16.0         COMPACT PARKING       16.0         15'-0" x 7'-6"       16.0         FS       16.0         COMPACT PARKING       15.0         15'-0" x 7'-6"       15.0         COMPACT PARKING       15.96         FS       15.0         COMPACT PARKING       15.8         15'-0" x 7'-6"       15.8         15'-0" x 7'-6"       15.8         15'-0" x 7'-6"       15.8         15.75       15.8	CLR.

REMARKS
BY MILLWORK
BY OWNER
BY MILLWORK

